


T.3S.R.4W.W.M.

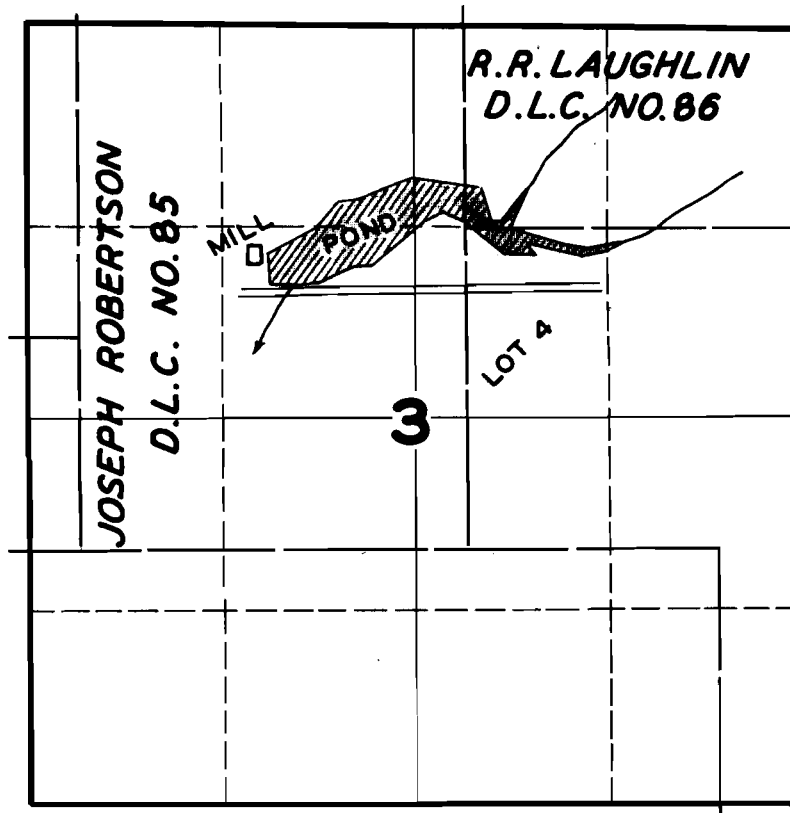

FINAL PROOF SURVEY

UNDER

R-18959

R-762

Application No. **18960** Permit No. **14910**

IN NAME OF

WM. J. SHAW

Surveyed **APR. 4** 1947, by **JAS. E. BUNNELL**