


**T.3S.R.4W.W.M.**

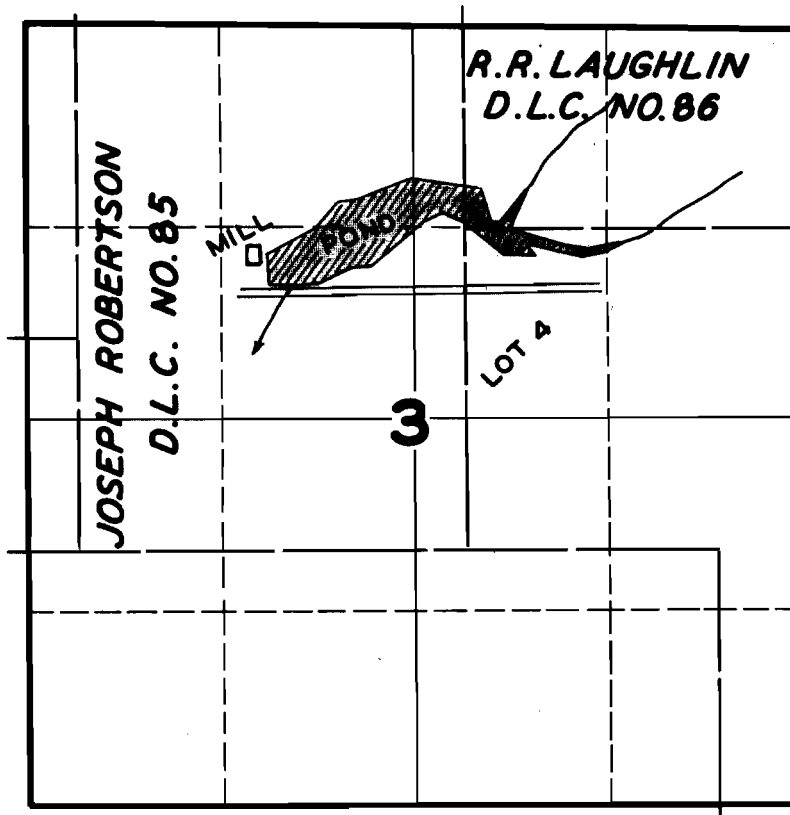

**FINAL PROOF SURVEY**

UNDER

**R-18959**

**R-762**

Application No. **18960** Permit No. **14910**

IN NAME OF

**WM. J. SHAW**

Surveyed **APR. 4** 1947, by **JAS. E. BUNNELL**