


T.2S.R.3W.W.M.

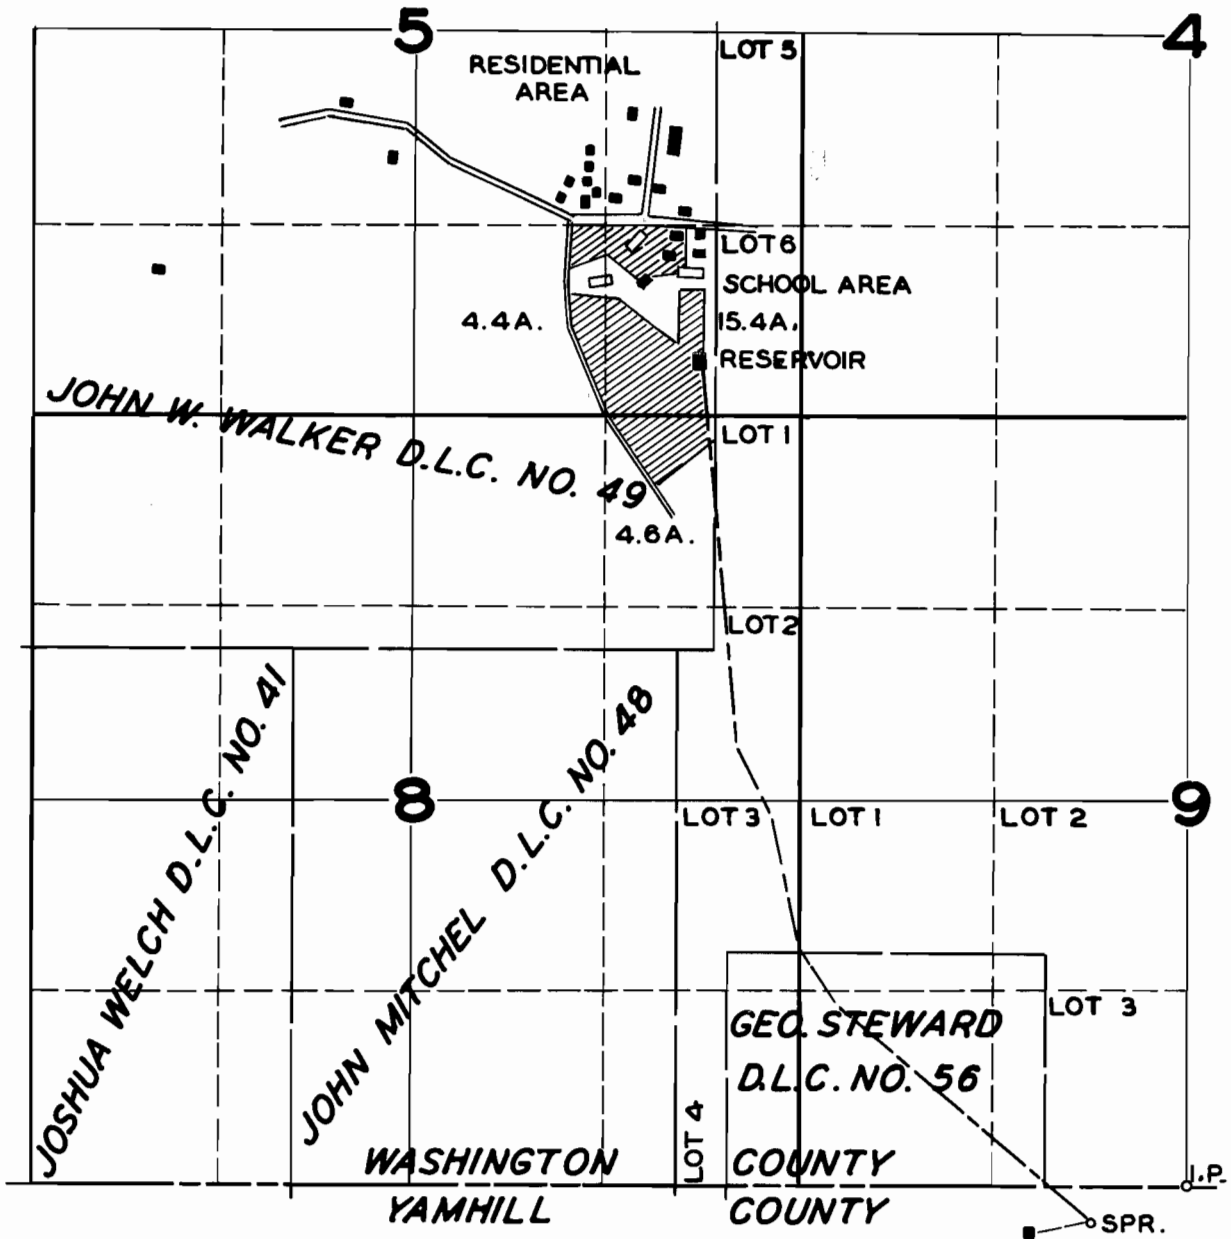

FINAL PROOF SURVEY

UNDER

R-20261

R-797

Application No. ~~20262~~ Permit No. ~~15925~~

IN NAME OF

WESTERN OREGON CONFERENCE ASSOC. OF SEVENTH-DAY ADVENTISTS

Surveyed MAY 25, 1948, by JAS. E. BUNNELL