


T.5S.R.1E.W.M.

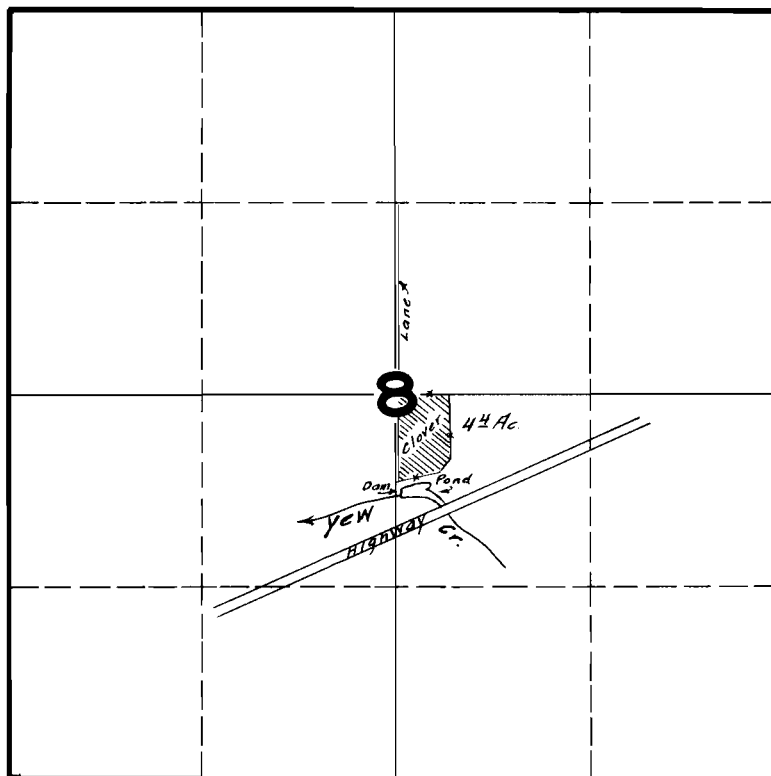

FINAL PROOF SURVEY

UNDER

R-20442

R-799

Application No. 20443 Permit No. 15962

IN NAME OF

OSCAR H. AASLAND

Surveyed OCT. 27 1947, by JAS. E. BUNNELL