


# T. 2S. R. 1E. W. M.

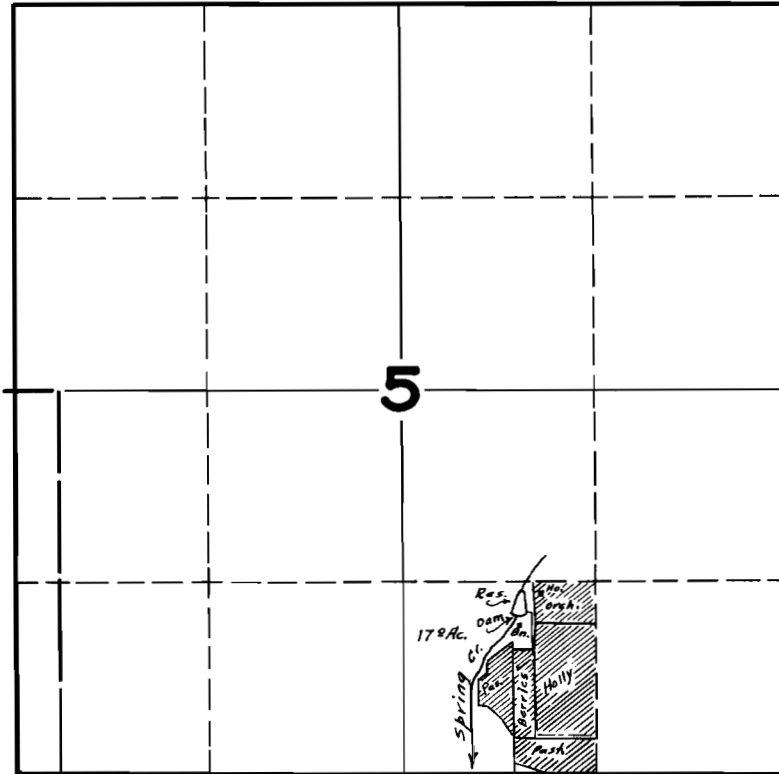

## FINAL PROOF SURVEY

R-20464 UNDER  
20465

R-800  
15977

Application No. 19011 Permit No. 14700


IN NAME OF

A. W. RHODES


Surveyed JUNE 17 1946, by

Handwritten signature of the surveyor, likely J. H. Bunnell.


FINAL SURVEY SURVEYED, PLOTTED, AND CHECKED BY: DATE: NO. AREAS CHECKED:

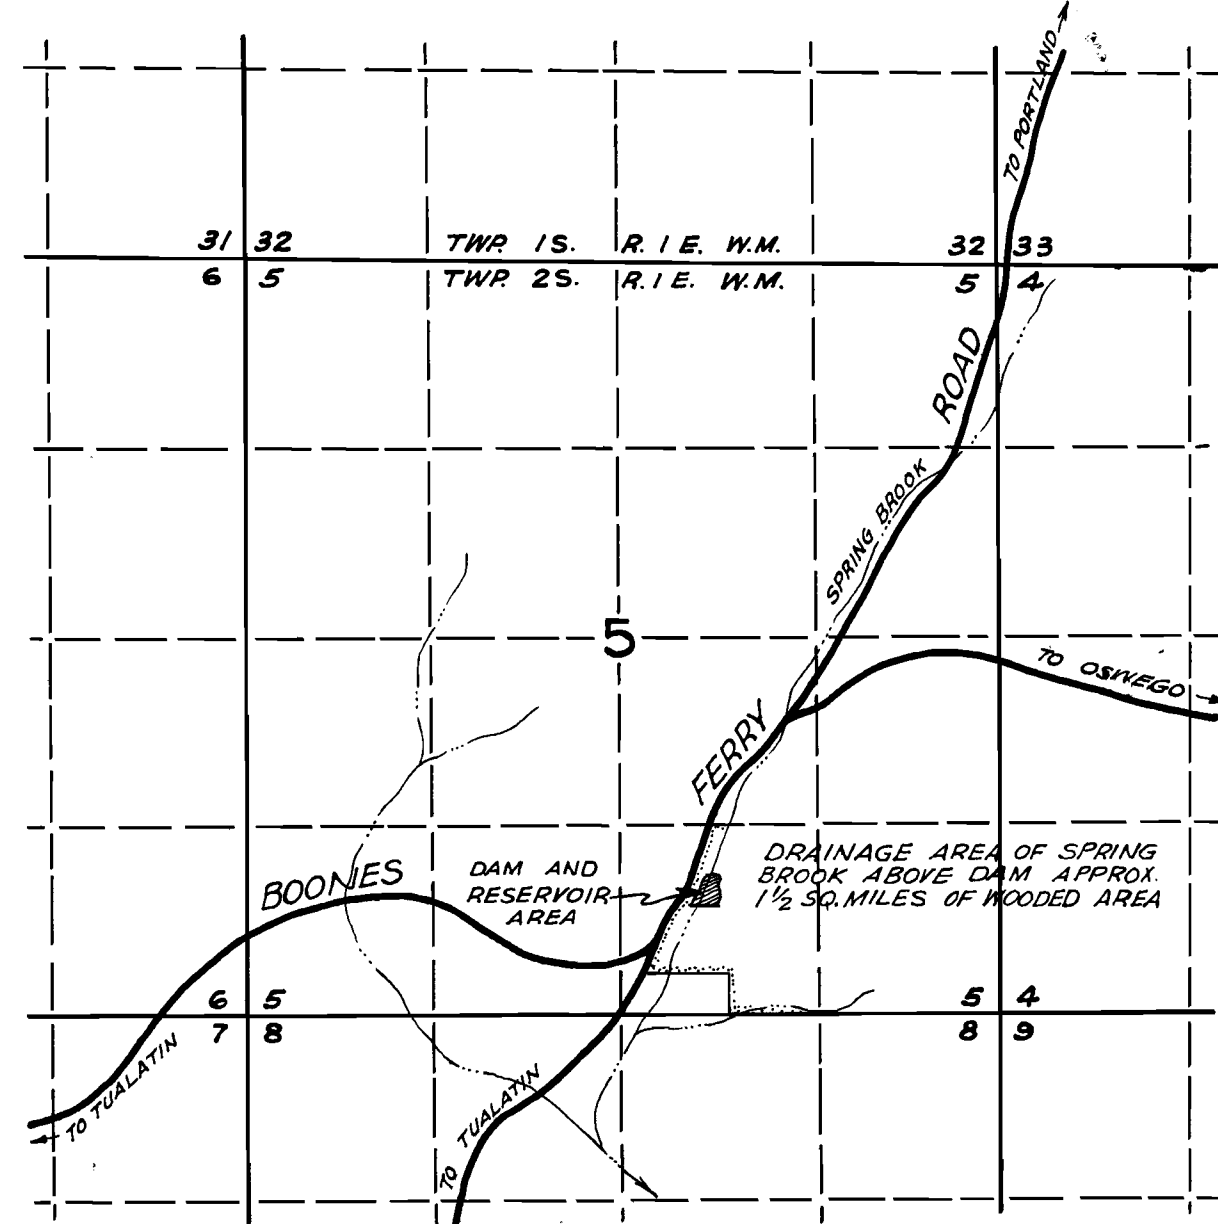

VICINITY MAP  
SCALE 4 INCHES = 1 MILE


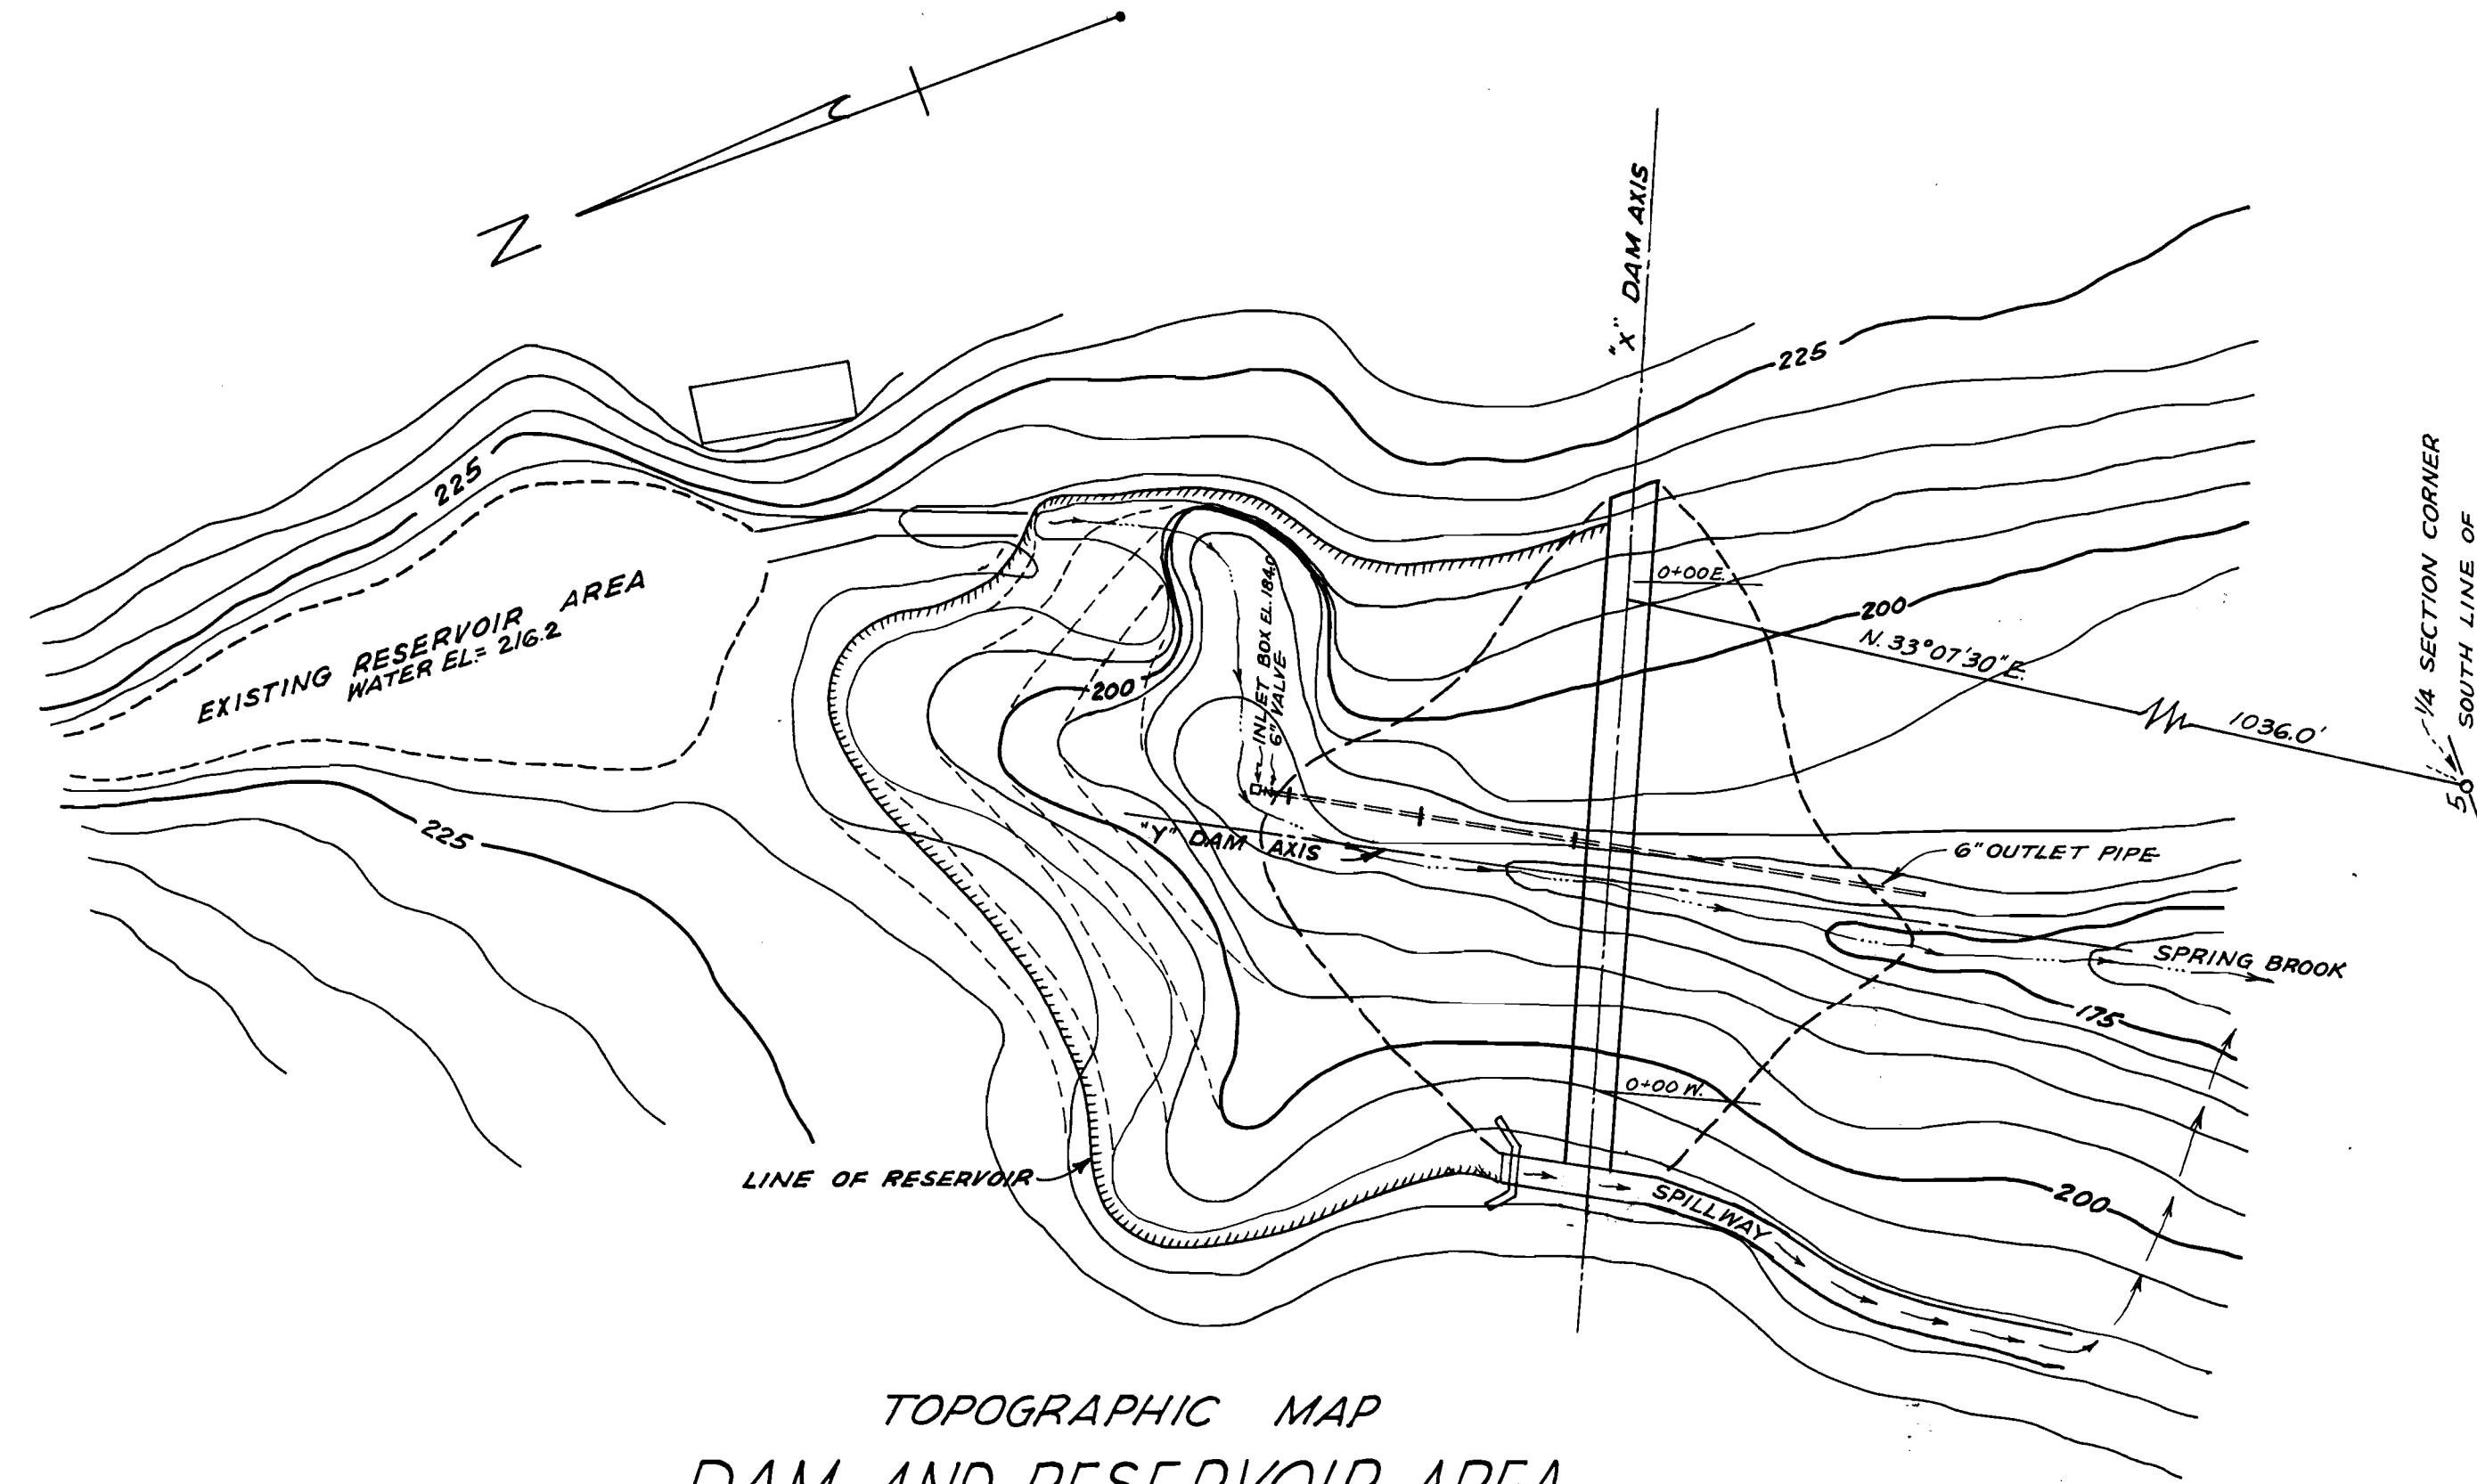


TOPOGRAPHIC MAP  
DAM AND RESERVOIR AREA  
SCALE 1" = 50'

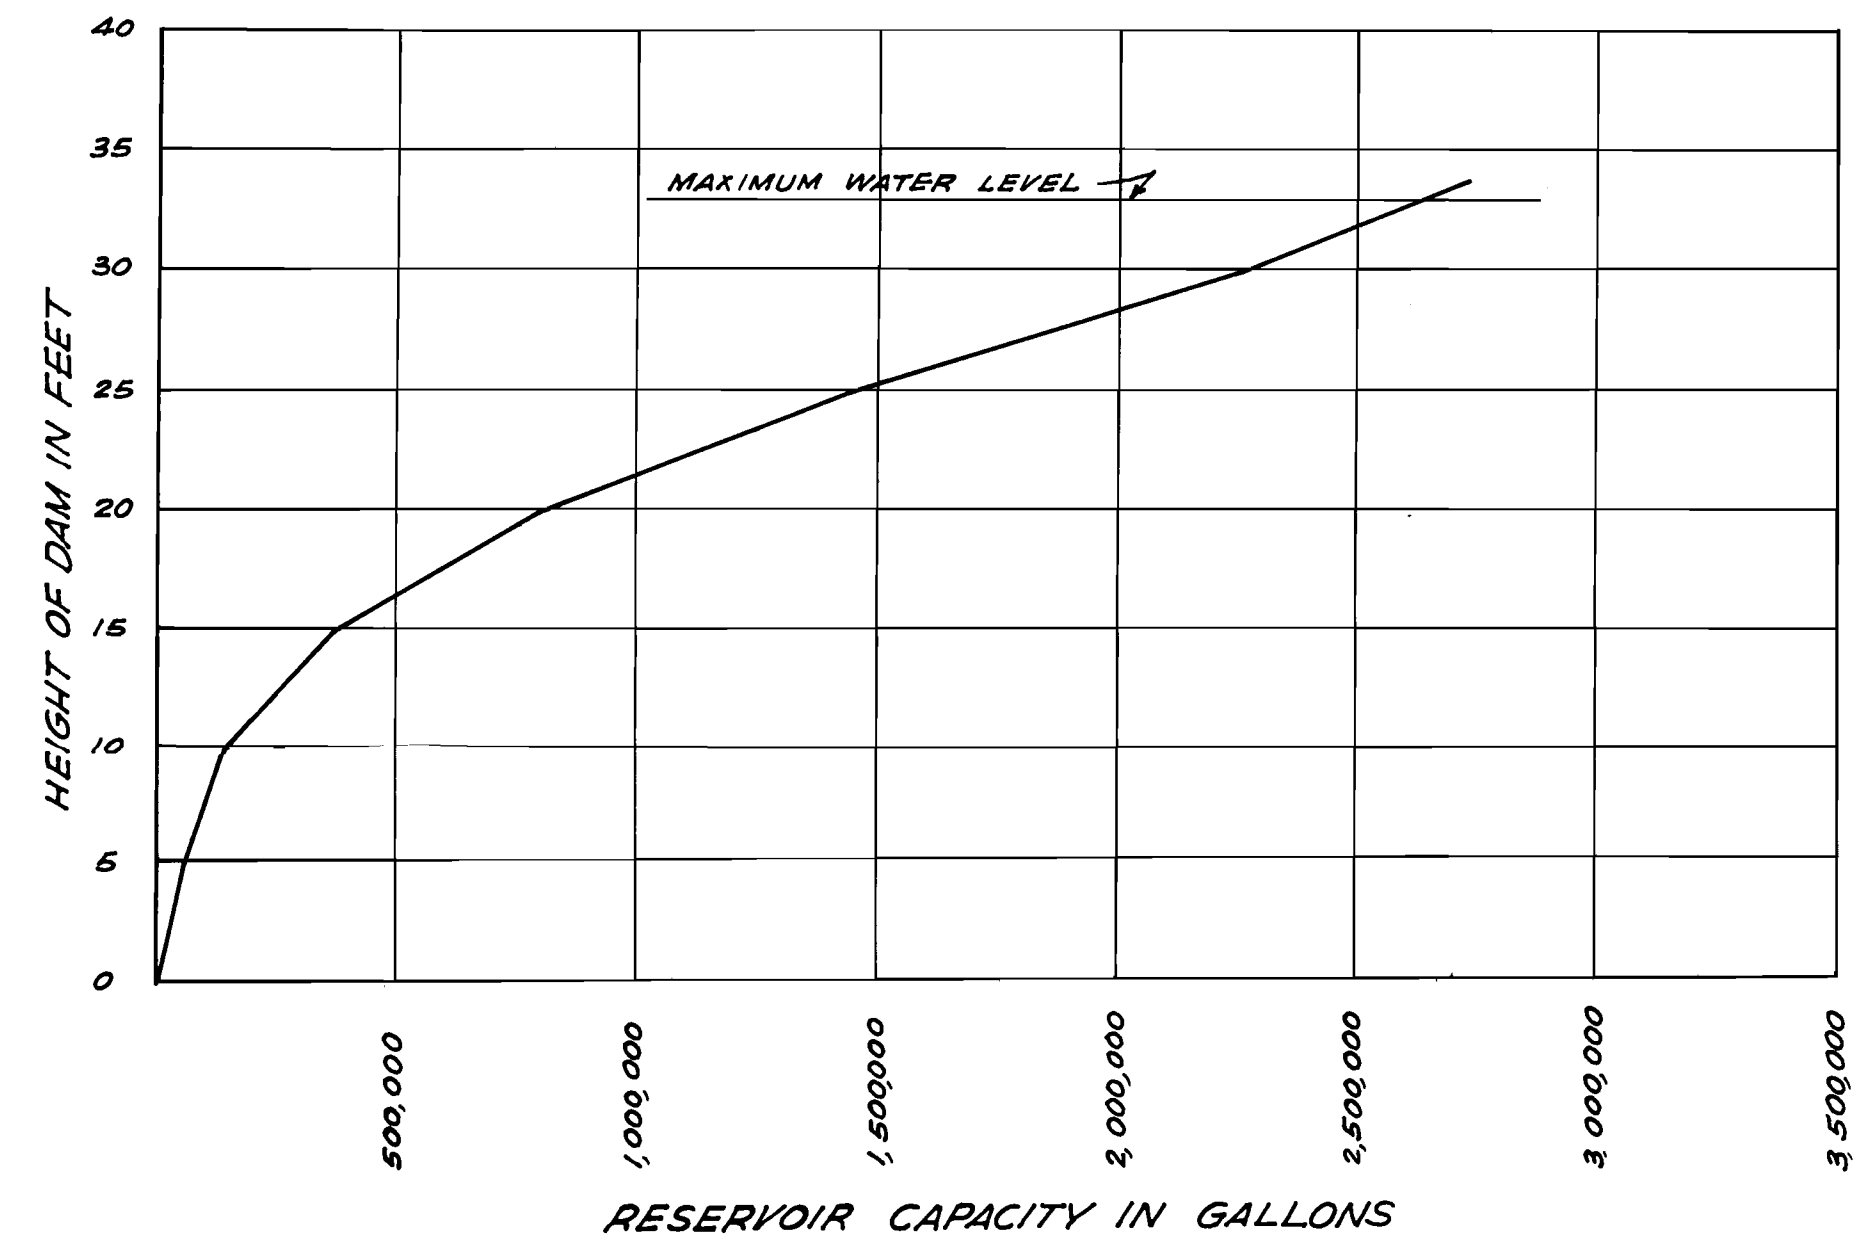

Application No. R-23691  
Permit No. 23718  
R. 920  
18730

ORIGINAL SURVEY SURVEYED, PLOTTED, AND CHECKED BY: DATE: NO. AREAS CHECKED:

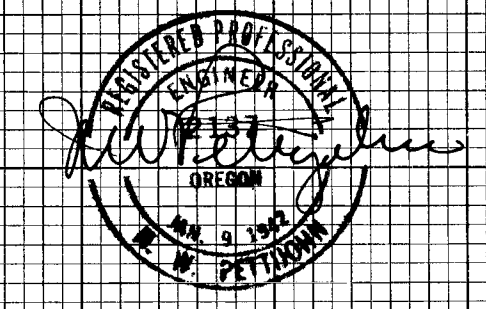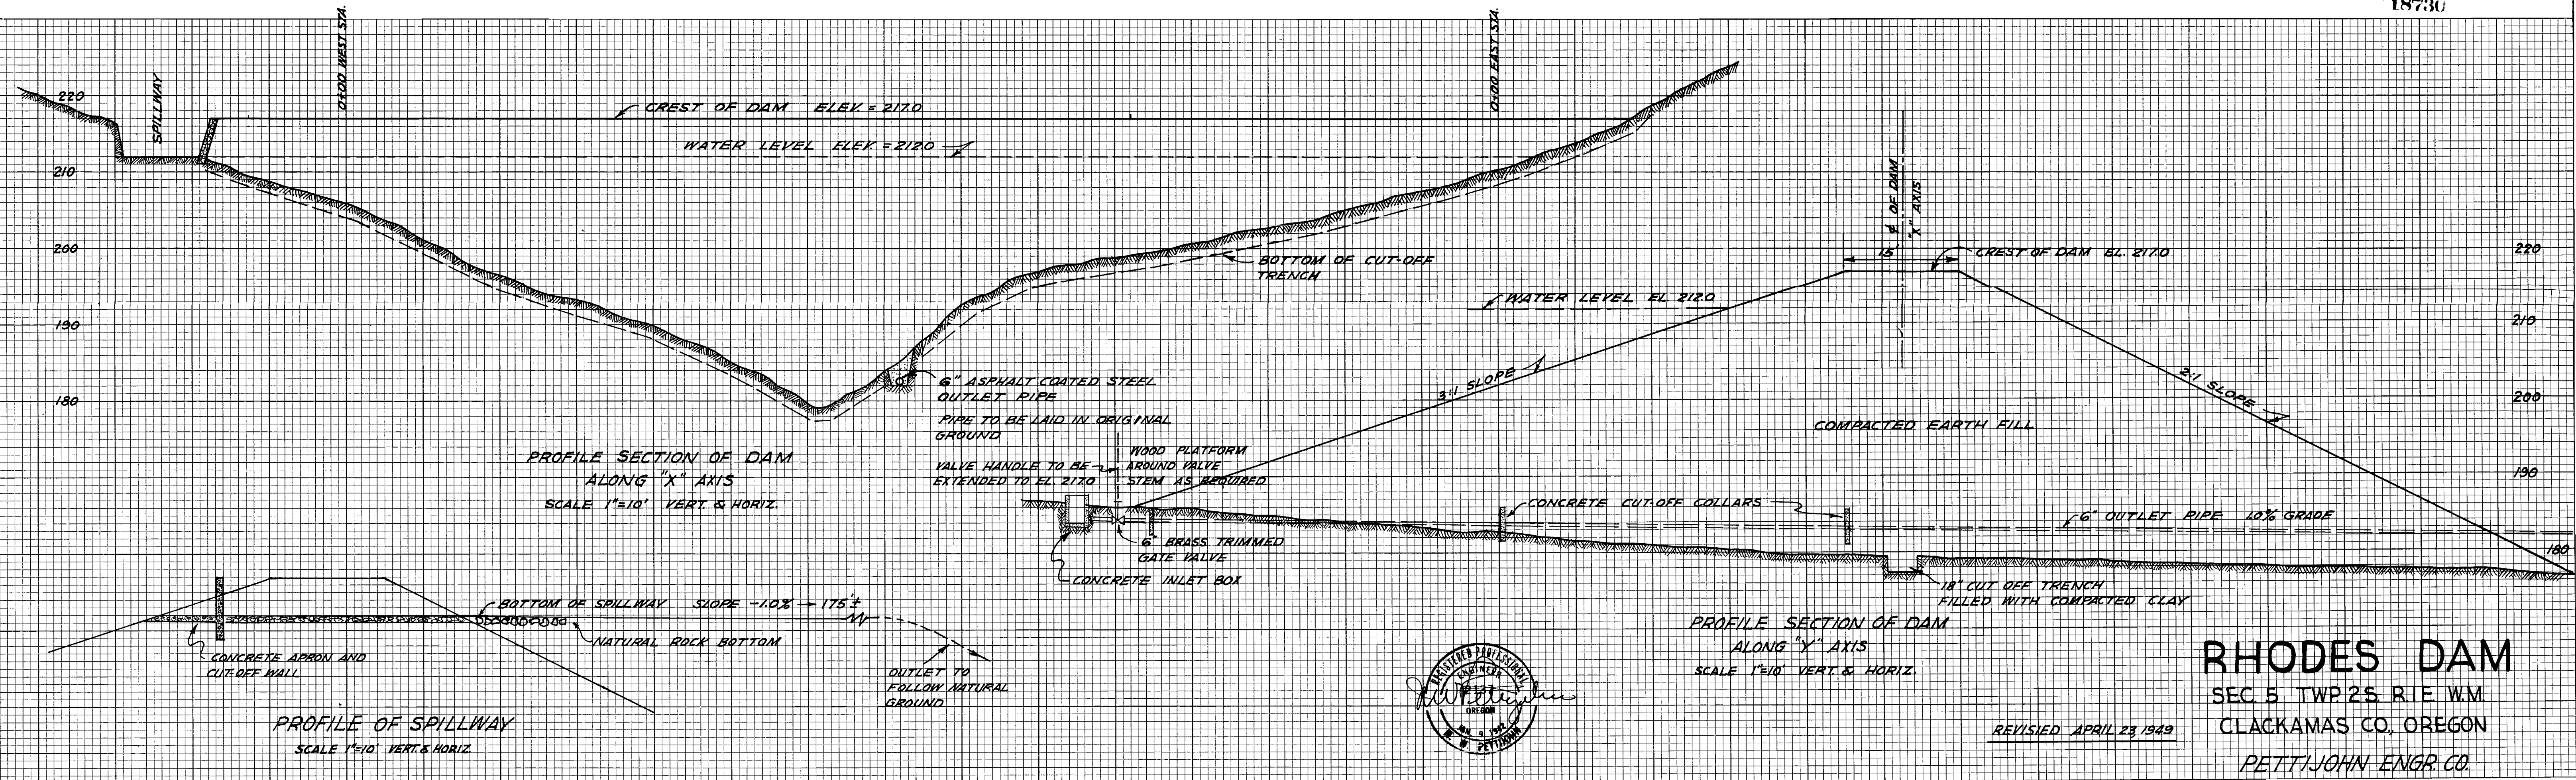

**RHODES DAM**  
SEC. 5 TWP. 2S. R. 1E. W.M.  
CLACKAMAS CO., OREGON  
PETTIJOHN ENGR. CO.

REVISED APRIL 23, 1949