


T.4S.R.2W.W.M.

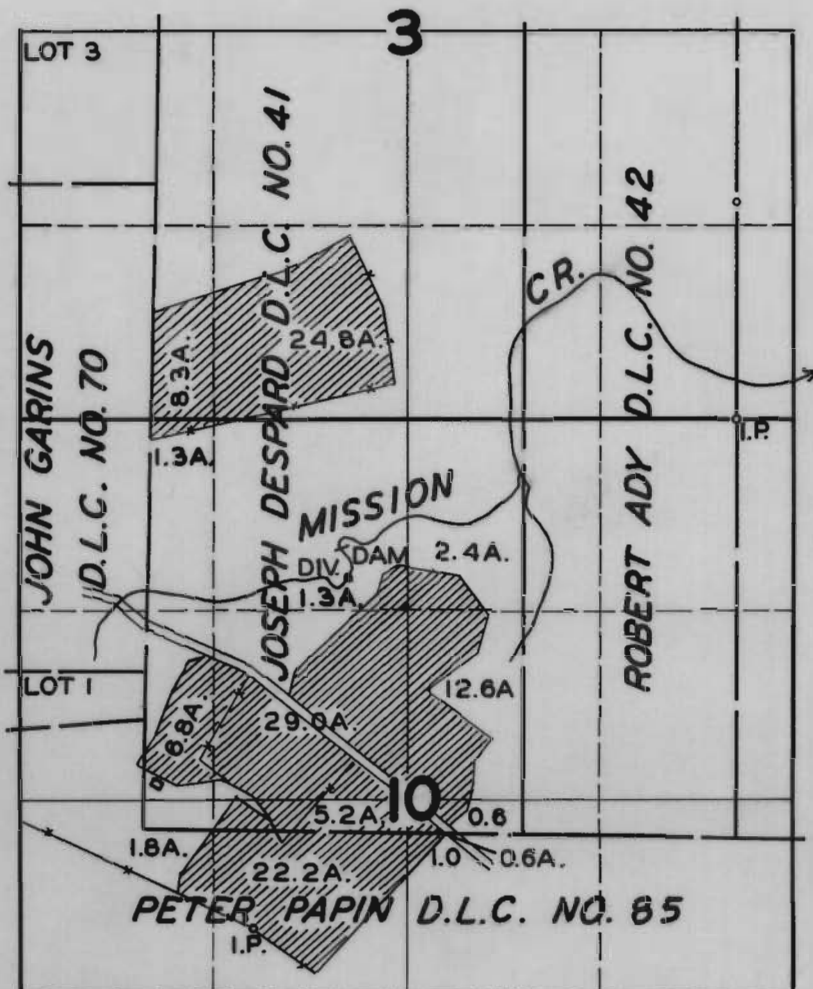

FINAL PROOF SURVEY

UNDER

20873

16463

Application No. R-20874 Permit No. R-820..

IN NAME OF

F. T. WILCOX

Surveyed SEP. 16, 1948, by JAS. E. BUNNELL