


T. 7 S. R. 10 W. W. M.

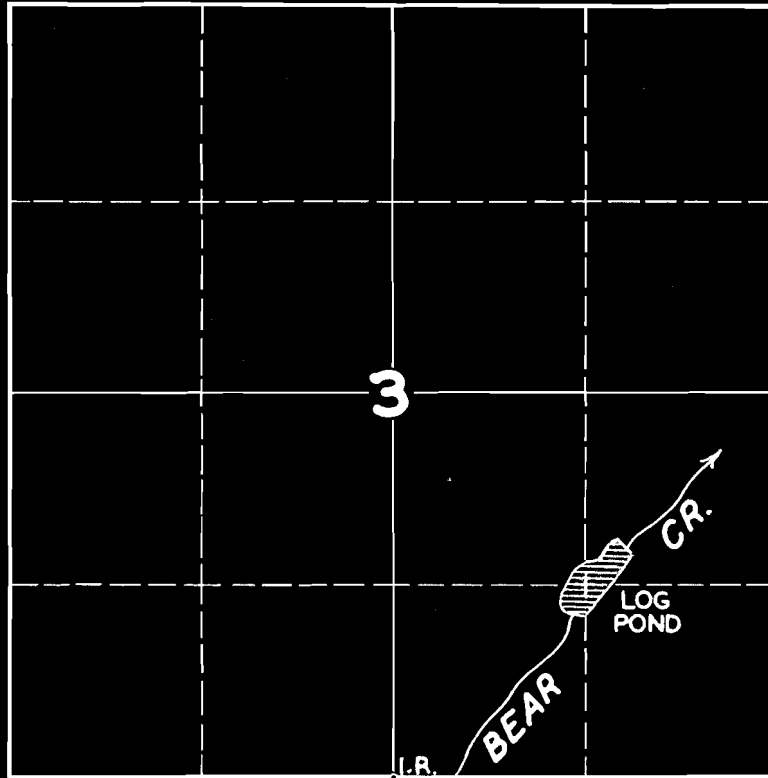

FINAL PROOF SURVEY

UNDER

R-22522 R-900
Application No. 22523 Permit No. 17909

IN NAME OF

I.O. NIEMI

Surveyed AUG. 11, 1948, by JAS. E. BUNNELL