


T. 7 S. R. 10 W. W. M.

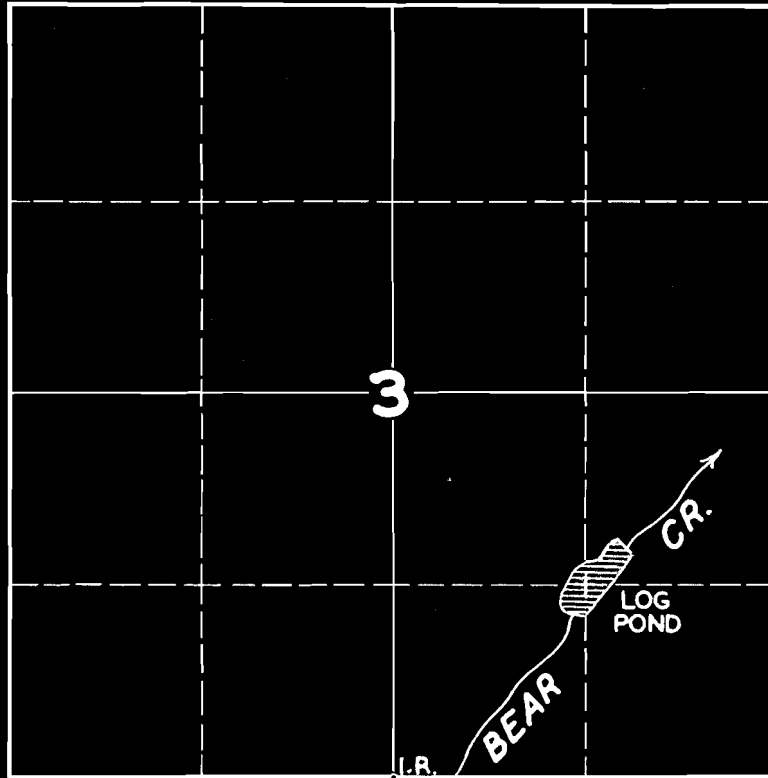

**FINAL PROOF SURVEY**

UNDER

Application No. **R-22522** Permit No. **R-900**  
**22523** **17909**

IN NAME OF

**I.O. NIEMI**

Surveyed **AUG. 11, 1948**, by **JAS. E. BUNNELL**