


# T.9S.R.2E.W.M.

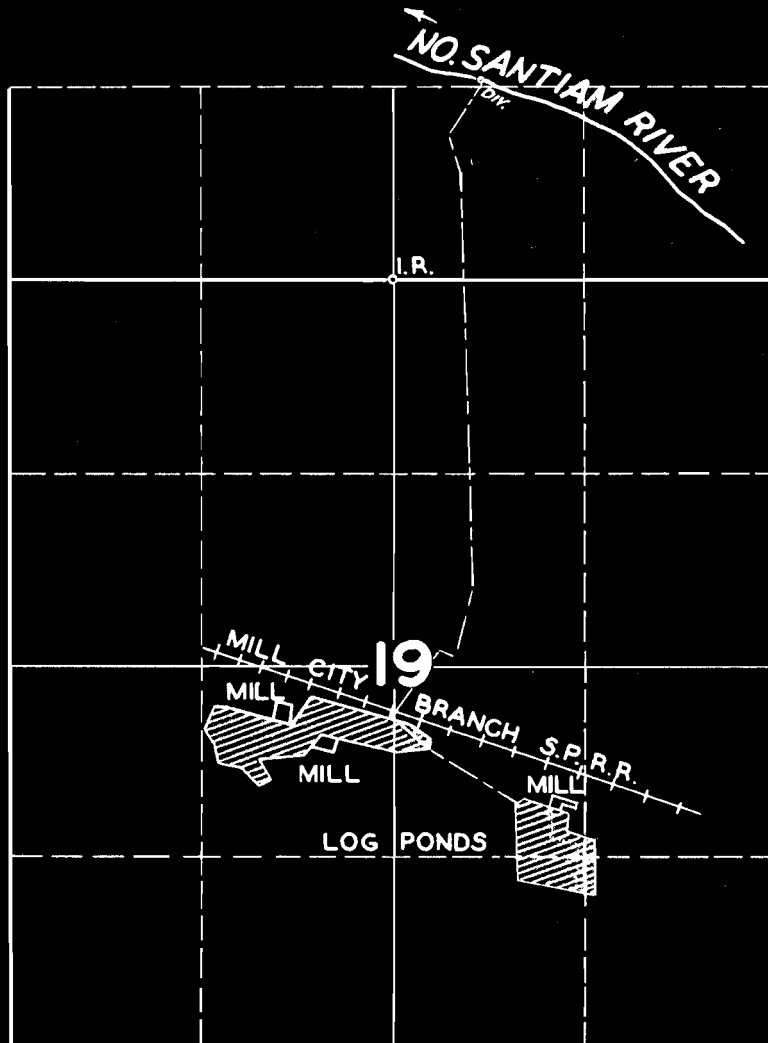

## FINAL PROOF SURVEY

UNDER

R-22437

R-924

Application No. 22438 Permit No. 18114

IN NAME OF

FRERES LUMBER CO. & MT. JEFFERSON LUMBER CO.

MAY 10  
Surveyed AUG. 27, 1948, by JAS. E. BUNNELL