


T.9S.R.2E.W.M.

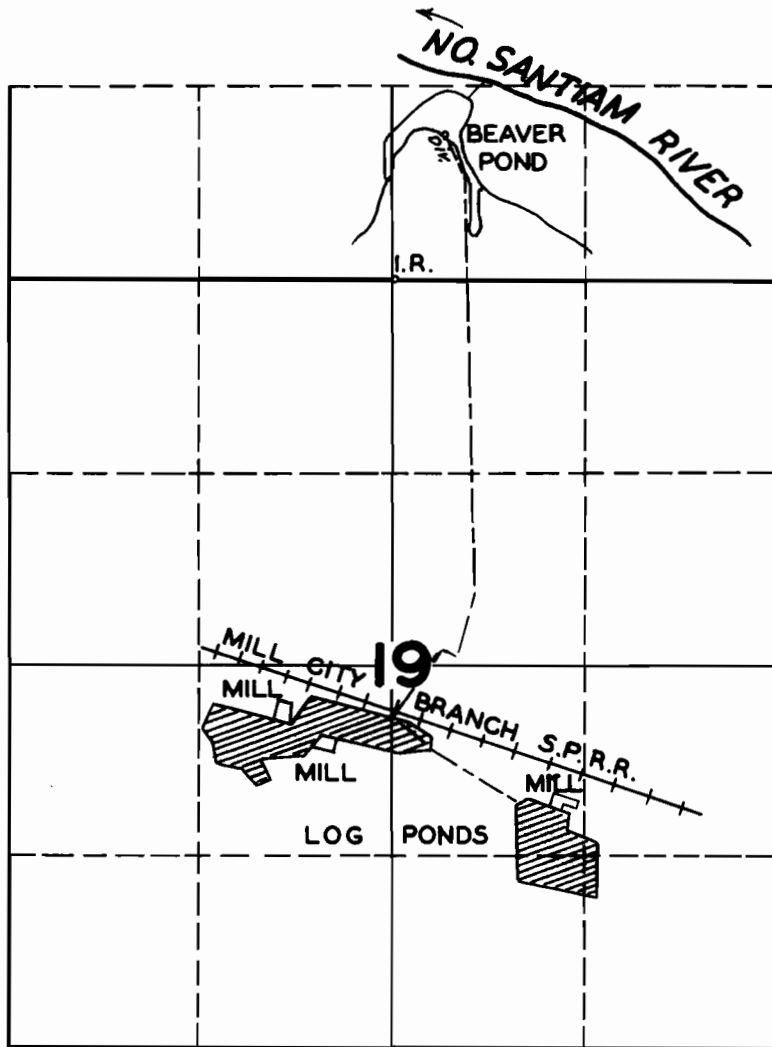

FINAL PROOF SURVEY UNDER

Application No. **23050** Permit No. **18157**
IN NAME OF

FRERES LUMBER CO. & MT. JEFFERSON LUMBER CO.

Surveyed **AUG. 27 1948**, by **JAS. E. BUNNELL**