


T.10S.R.6E.W.M.

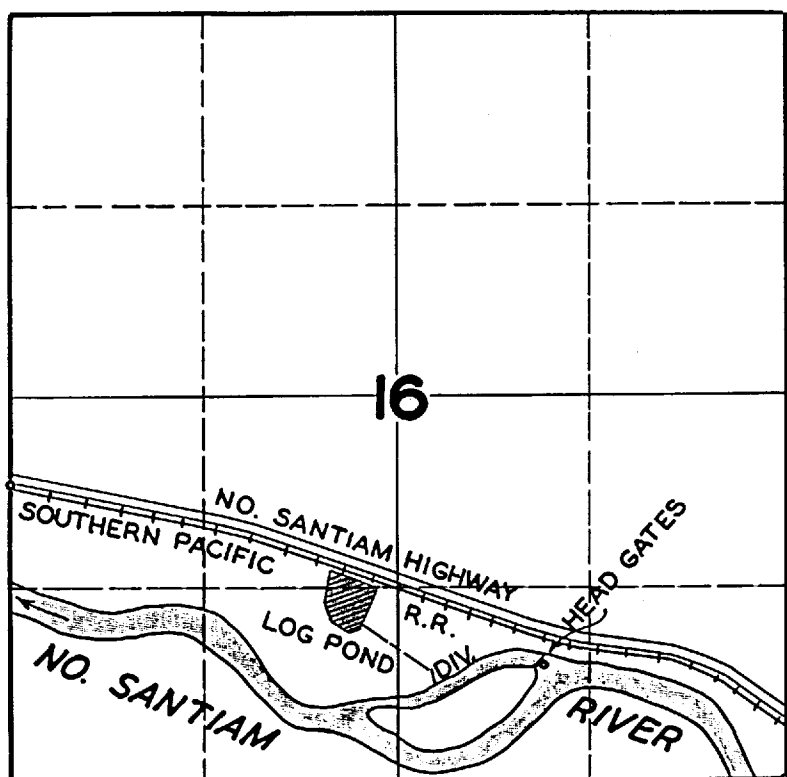

FINAL PROOF SURVEY

UNDER

R-22966

R-926

Application No. 22967.. Permit No. 18127.....

IN NAME OF

IDANHA LUMBER CO.

Surveyed OCT. 12, 1948, by JAS. E. BUNNELL