


T.13S. R.1E.W.M.

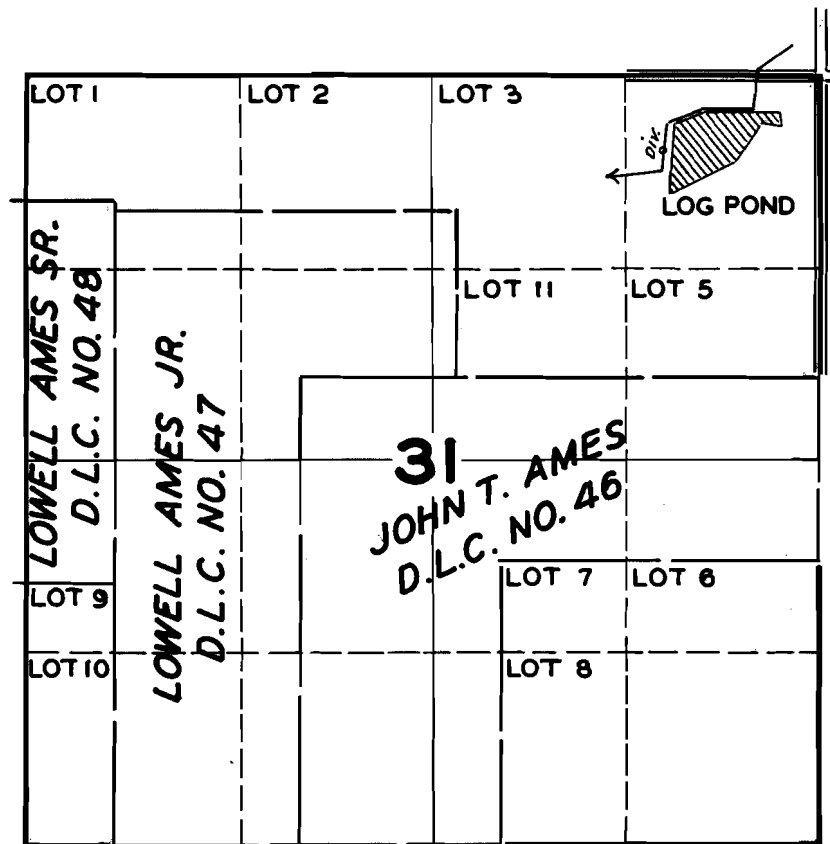

FINAL PROOF SURVEY

UNDER

R-23277

R-944

Application No. ~~23294~~ Permit No. ~~18377~~

IN NAME OF

WEST GATE LUMBER COMPANY

Surveyed MAR. 29 1949, by JAS. E. BUNNELL