


T.27S.R.12W.W.M.

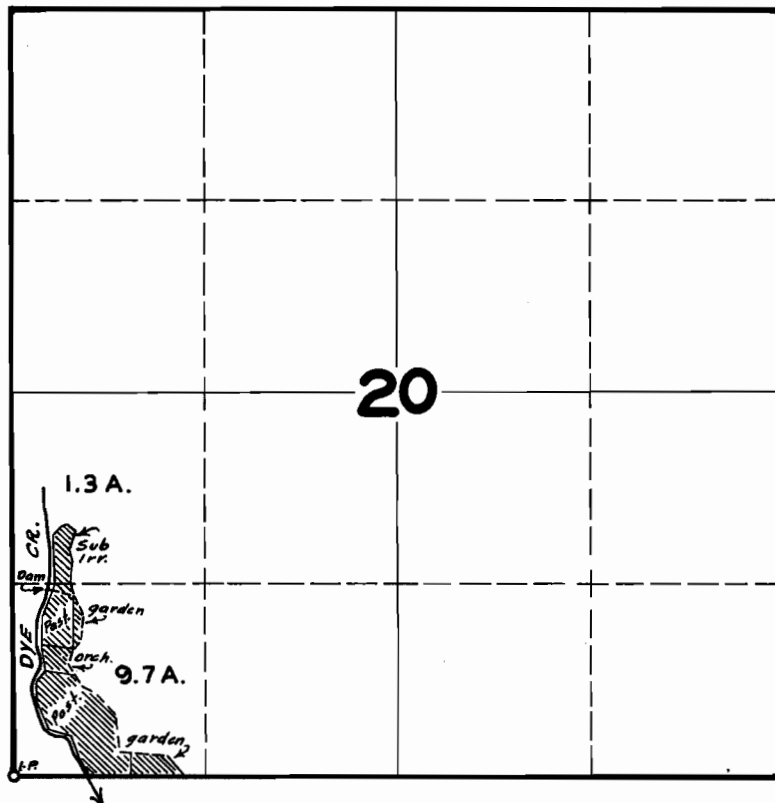

**FINAL PROOF SURVEY
UNDER**

Application No. 17929 Permit No. 13612

IN NAME OF

J. J. GEANEY

Surveyed AUG. 18. 1947, by JAS. E. BUNNELL