


T.4S.R.2W.W.M.

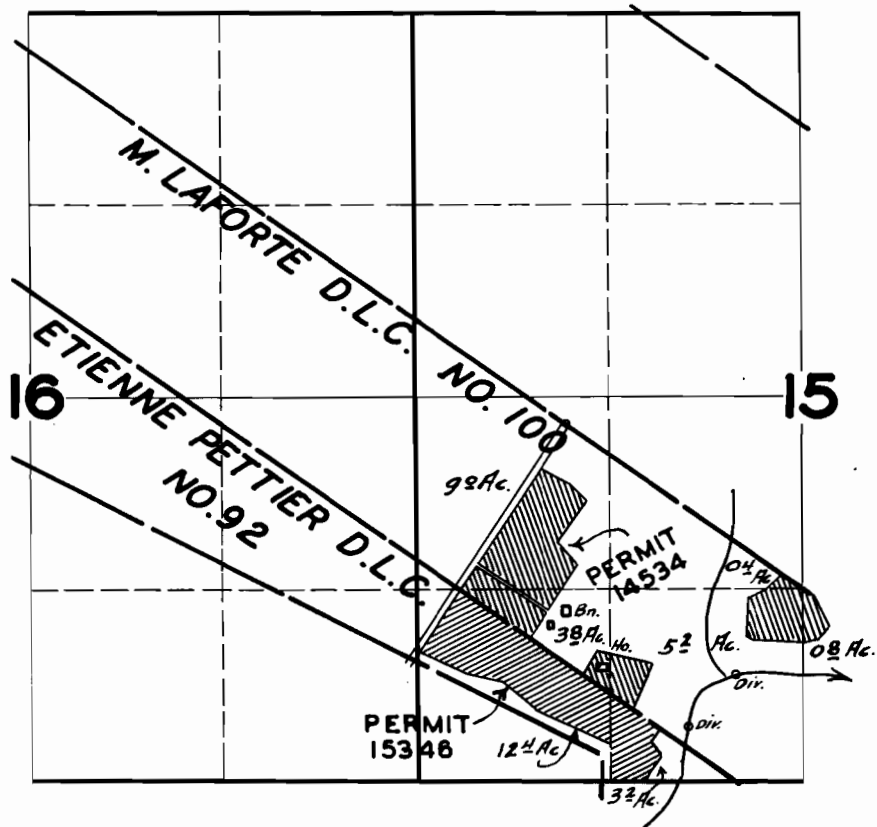

FINAL PROOF SURVEY

UNDER

Application No. 18924 Permit No. 14534
Application No. 19761 Permit No. 15346

IN NAME OF

ANNA K. BUYSERIE - ARTHUR R. & VESTA BUYSERIE

PERMIT 14534

PERMIT 15346

Surveyed AUG. 1, 1947, by JAS. E. BUNNELL