


T. 7S. R. 3W. W.M.

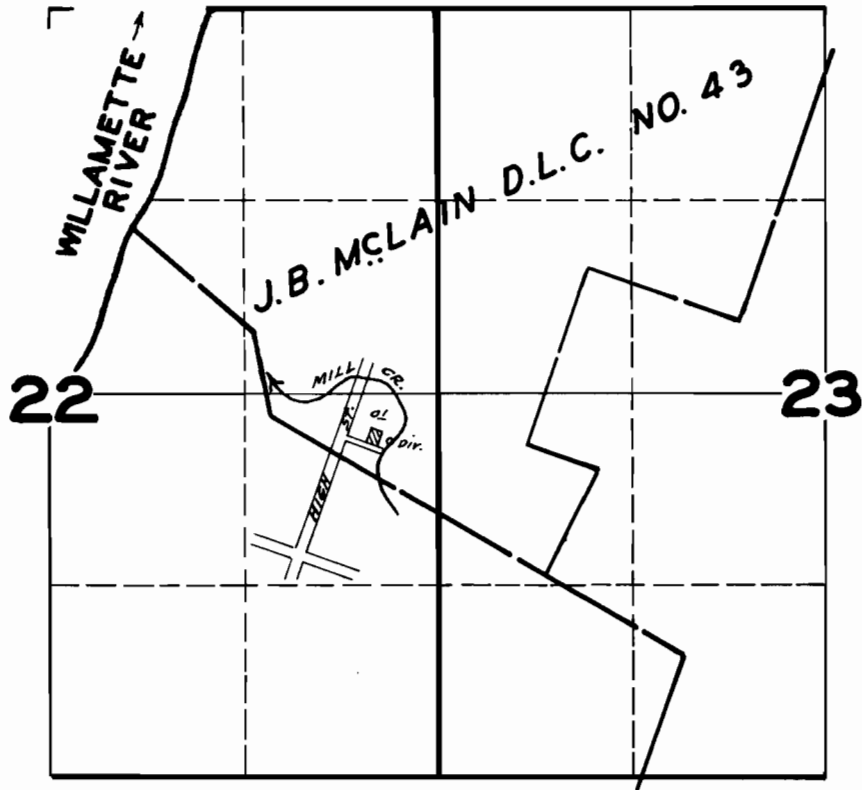

**FINAL PROOF SURVEY
UNDER**

Application No. 18904 Permit No. 14576
IN NAME OF
R.C. MAGEE

Surveyed AUG. 14, 1947, by JAS. E. BUNNELL