


T.8S.R.3W.W.M.

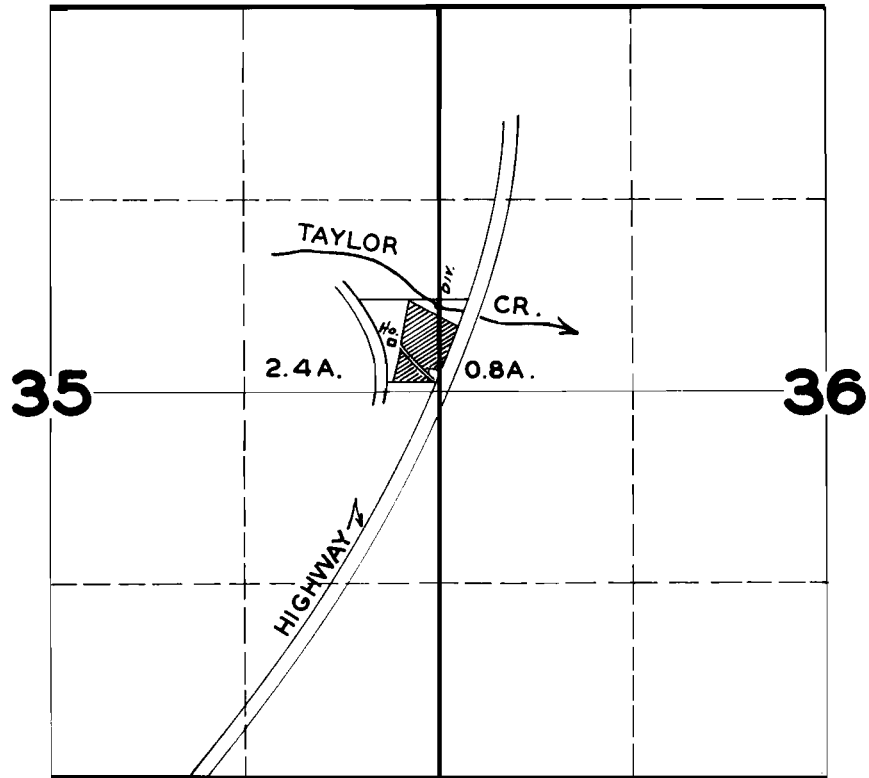

FINAL PROOF SURVEY UNDER

Application No. 19208 Permit No. 14801

IN NAME OF
MAX L. ALFORD

Surveyed OCT. 8, 1947, by JAS. E. BUNNELL