


T.8S.R.2W.W.M.

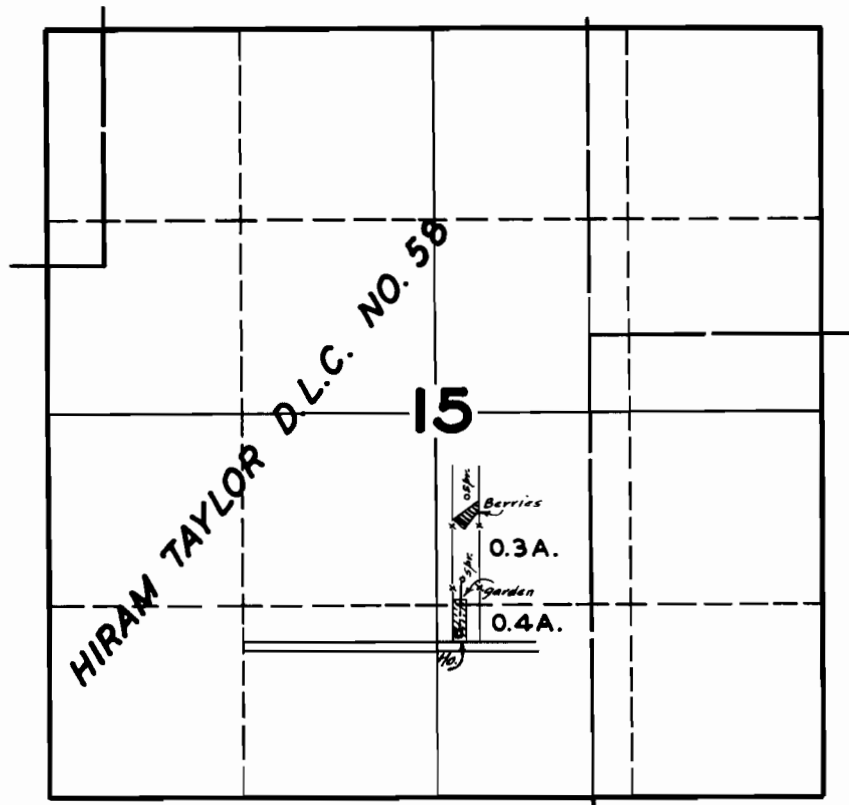

**FINAL PROOF SURVEY
UNDER**

Application No. 19455 Permit No. 15048

IN NAME OF

DWIGHT V. WEST

Surveyed SEP. 29 1947, by JAS. E. BUNNELL