


T.1N.R.7W.W.M.

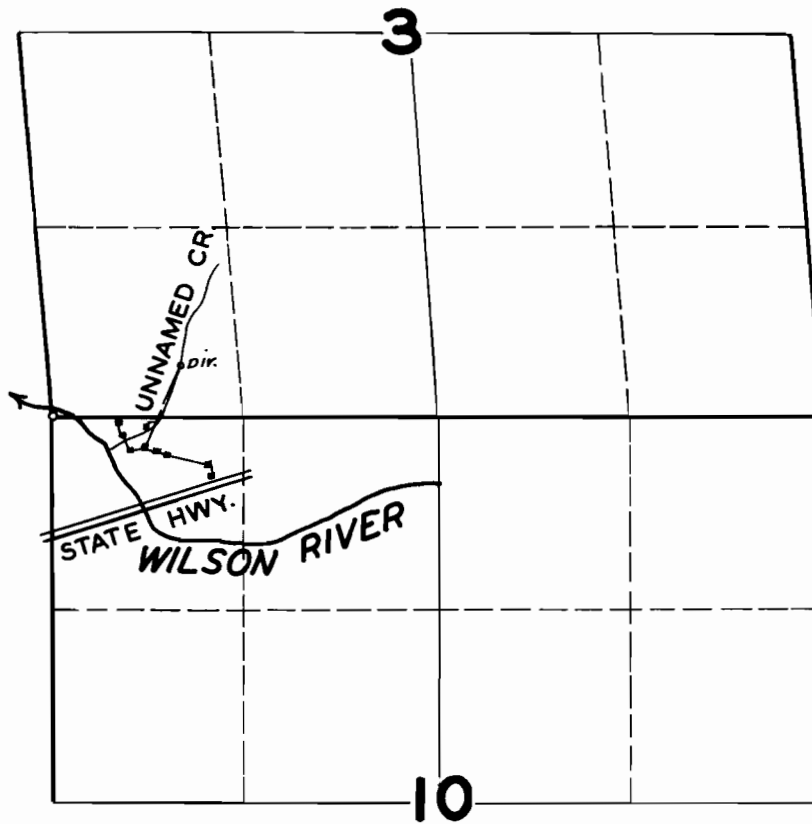

FINAL PROOF SURVEY
UNDER

Application No. 19646 Permit No. 15232
IN NAME OF
R. B. LEE

Surveyed SEP. 13, 1948, by JAS. E. BUNNELL