


**T.6S.R.IW.W.M.**

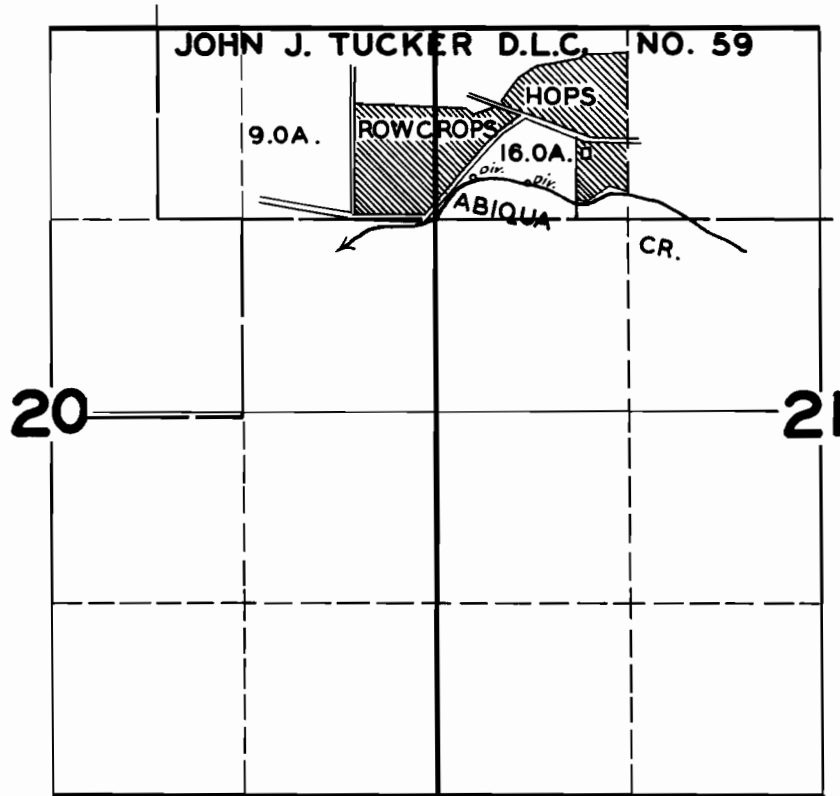

**FINAL PROOF SURVEY  
UNDER**

Application No. 19742 Permit No. 15329

**IN NAME OF**

JOSEPH B. GAFFKE

Surveyed OCT. 6 1947, by JAS. E. BUNNELL