


T.2S.R.44E.W.M.

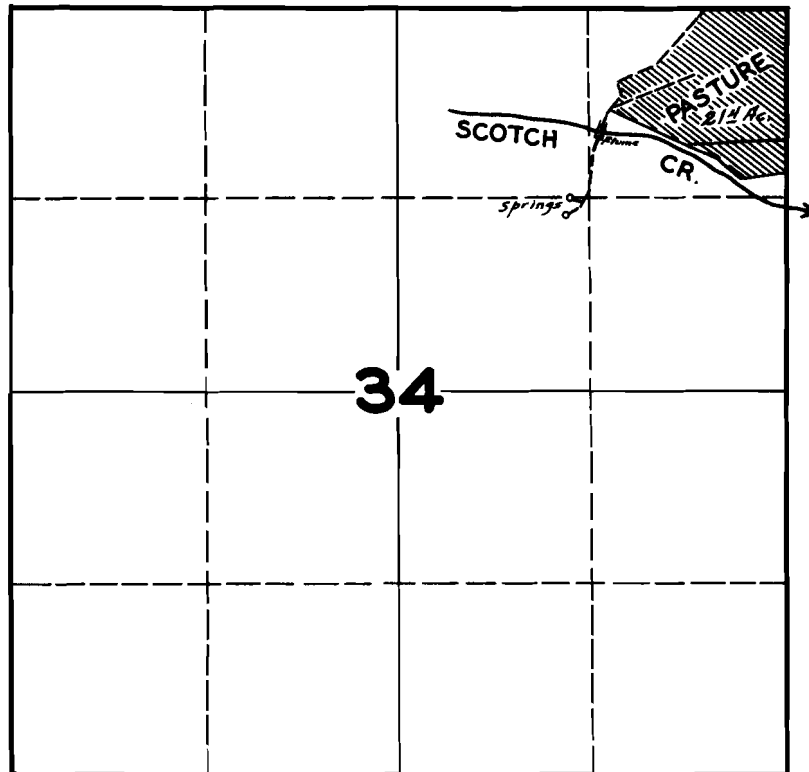

**FINAL PROOF SURVEY
UNDER**

Application No. 19651 Permit No. 15421

IN NAME OF

GARRETT S. LOVELL

Surveyed JUNE 26 1946, by JAS. E. BUNNELL