


T.12S.R.11W.W.M.

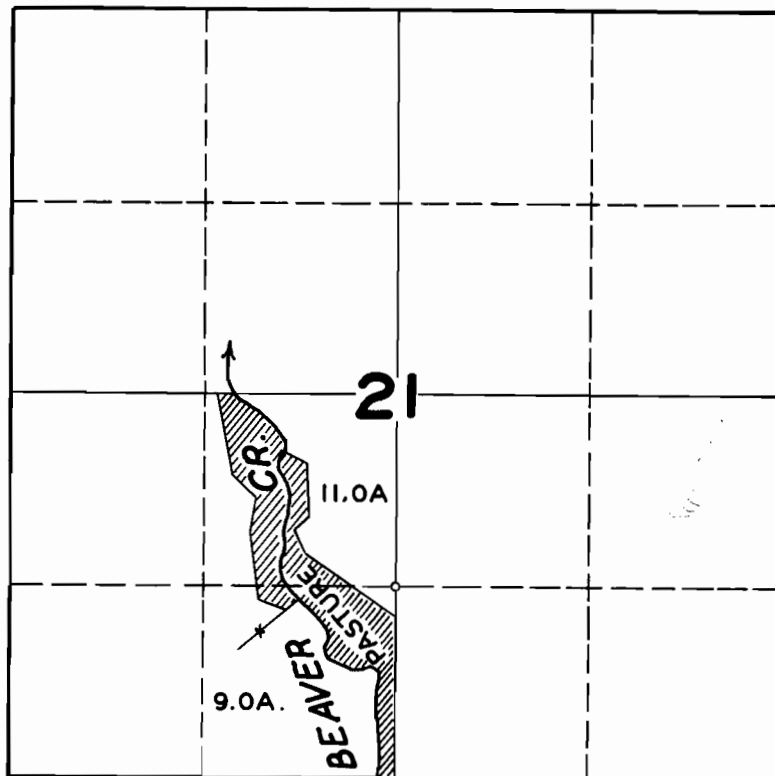

FINAL PROOF SURVEY
UNDER

Application No. **19874** Permit No. **15450**
IN NAME OF

E. L. WILSON

Surveyed **AUG. 2, 1948**, by **JAS. E. BUNNELL**