


# T. 7 S. R. 4 W. W. M.

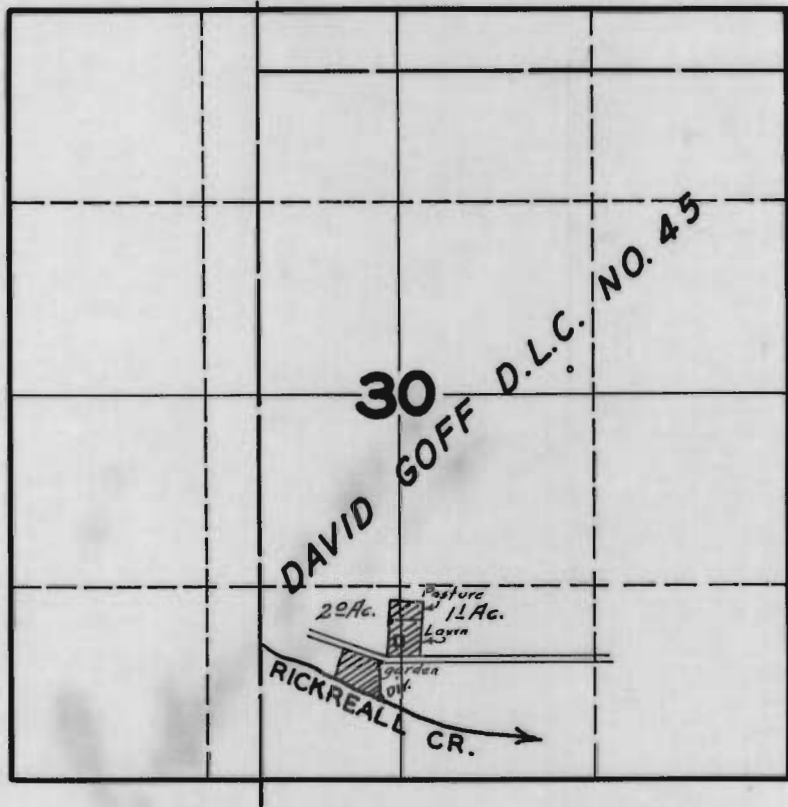

## FINAL PROOF SURVEY UNDER

Application No. 20001 Permit No. 15575  
IN NAME OF  
H. M. WAIT

Surveyed MAR. 14 1947, by JAS. E. BUNNELL