


T.30S.R.3W.W.M.

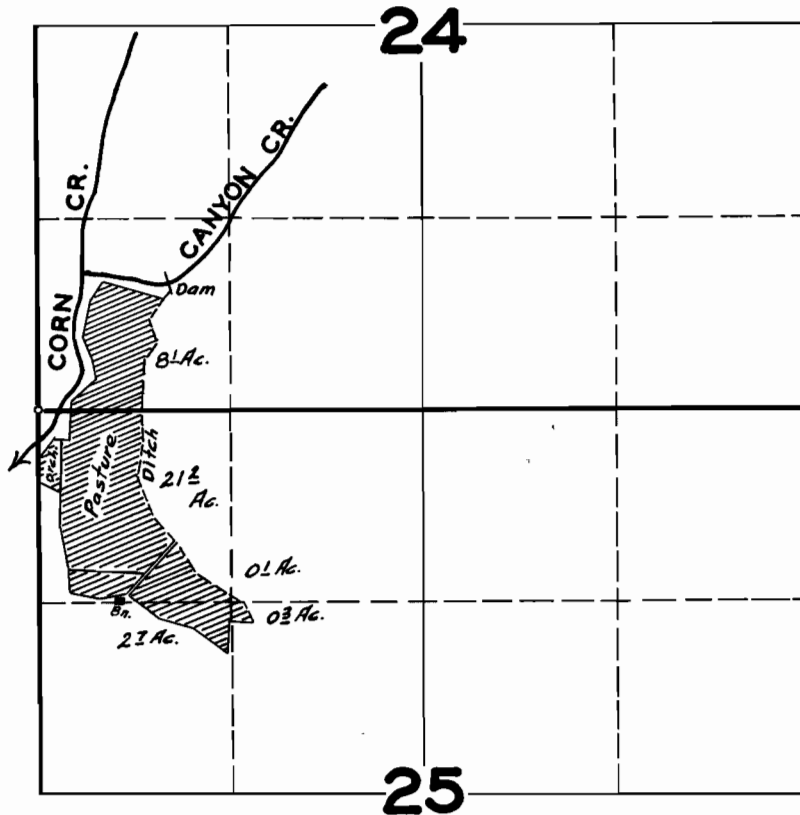

**FINAL PROOF SURVEY**  
UNDER

Application No. 18887 Permit No. 14391

IN NAME OF

KARL S. STAATS

Surveyed JUNE 3, 1947, by JAS. E. BUNNELL