


T.15S.R.8W.W.M.

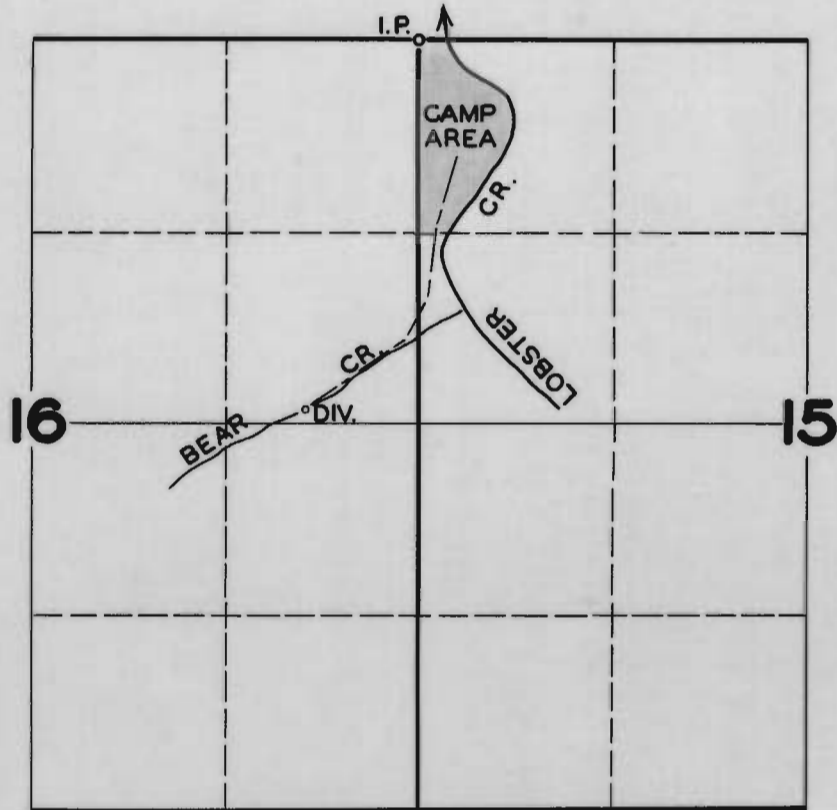

FINAL PROOF SURVEY
UNDER

Application No. **19189** Permit No. **14786**
IN NAME OF

EASTERN & WESTERN LUMBER CO.

Surveyed **JUNE 29 1948**, by **JAS. E. BUNNELL**