


T.4S.R.3W.W.M.

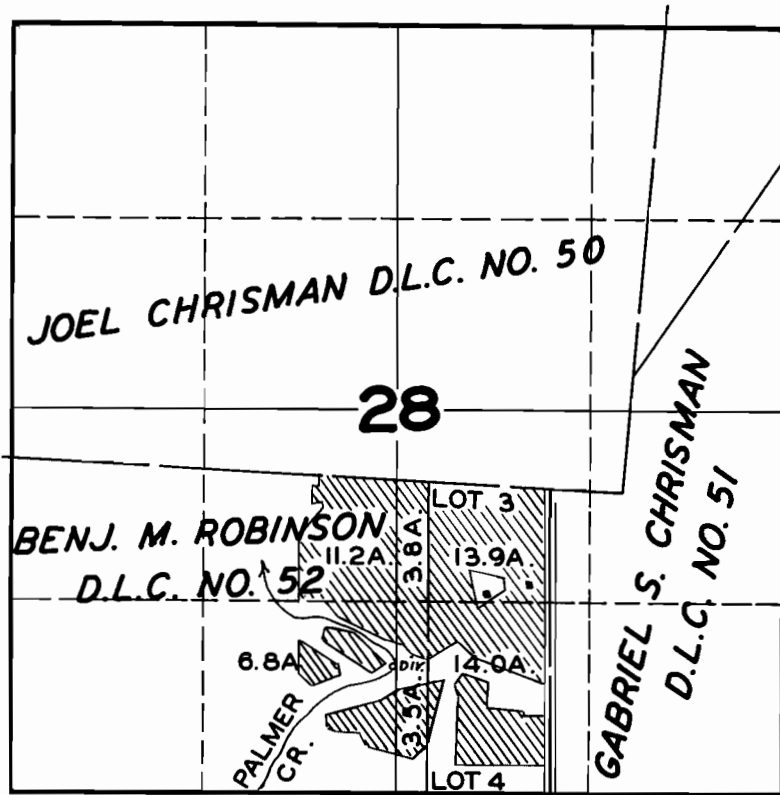

FINAL PROOF SURVEY

UNDER

Application No. **20367** Permit No. **15887**

IN NAME OF

CARL RUTSCHMAN

Surveyed **JUNE 2, 1948**, by **JAS. E. BUNNELL**