


T.17S.R.6W.W.M.

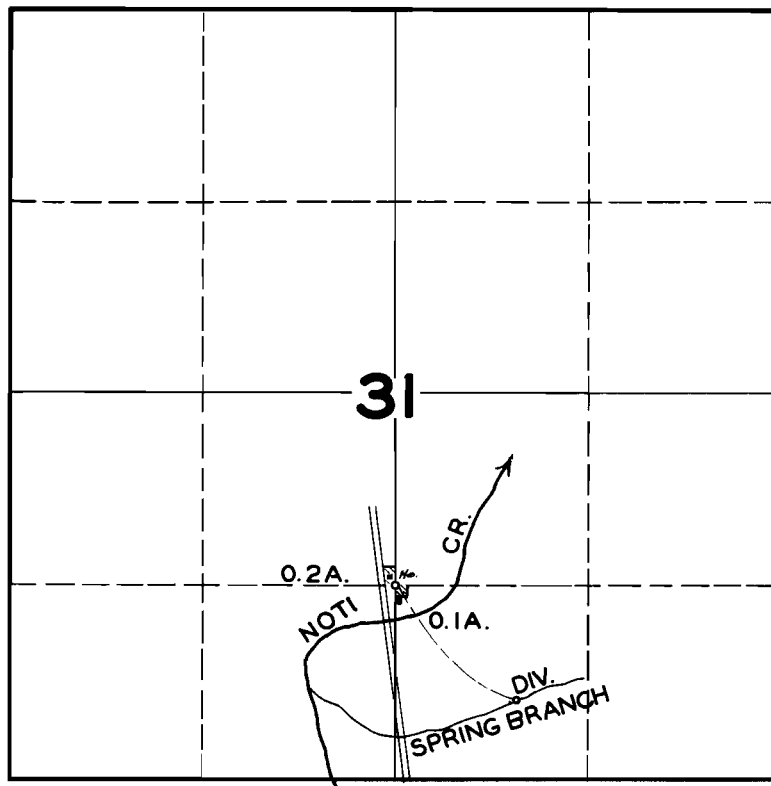

FINAL PROOF SURVEY
UNDER

Application No. **20447** Permit No. **15966**
IN NAME OF

JAMES L. GREGORY

Surveyed **JULY 21 1948**, by **JAS. E. BUNNELL**