


T.28S.R.7W.W.M.

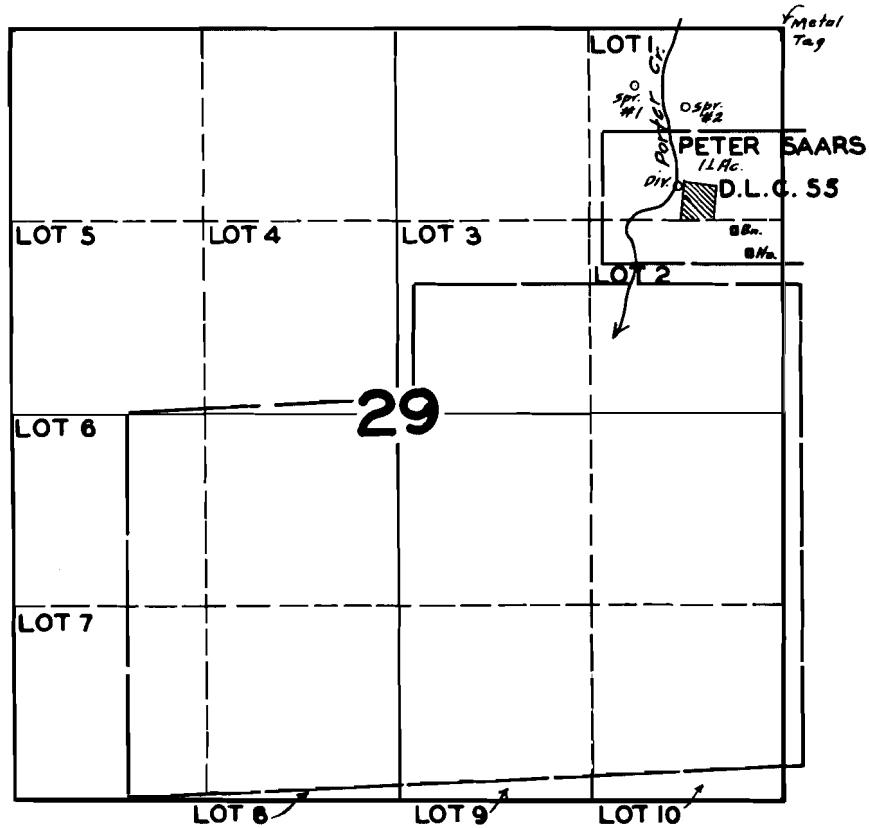

FINAL PROOF SURVEY

UNDER

20611

16103

Application No. 22039 Permit No. 17402

IN NAME OF

JAMES A. HENRY

Surveyed JUNE 5 1947, by JAS. E. BUNNELL