


T.18S.R.3W.W.M.

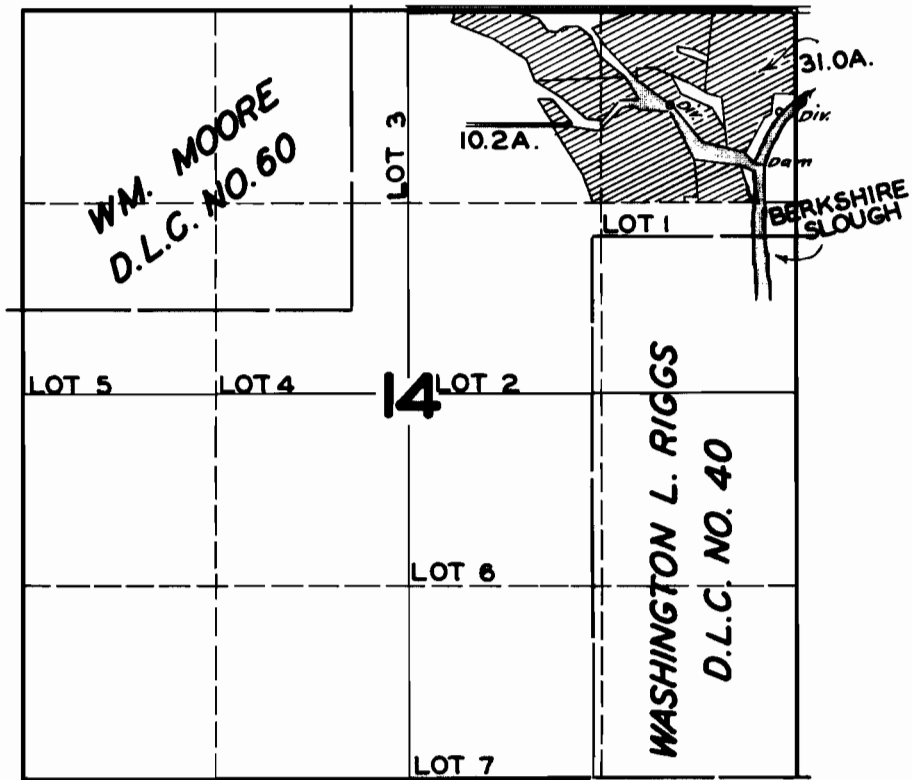

FINAL PROOF SURVEY

UNDER

Application No. 20593 Permit No. 16119

IN NAME OF

RALPH S. WILLOUGHBY

Surveyed JUNE 22 1948, by JAS. E. BUNNELL