


**T.36S.R.14W.W.M.**

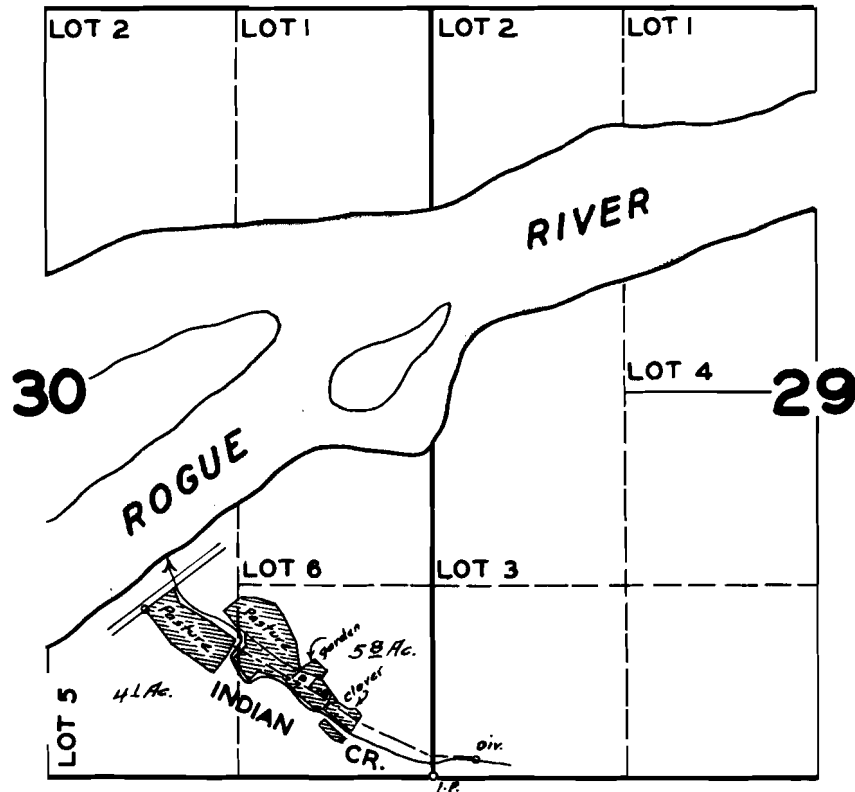

**FINAL PROOF SURVEY  
UNDER**

**Application No. 20637 Permit No. 16142**

**IN NAME OF  
ROBERT M. KNOX**

**Surveyed JUL. 23 1947, by JAS. E. BUNNELL**