


T.16S.R.5E.W.M.

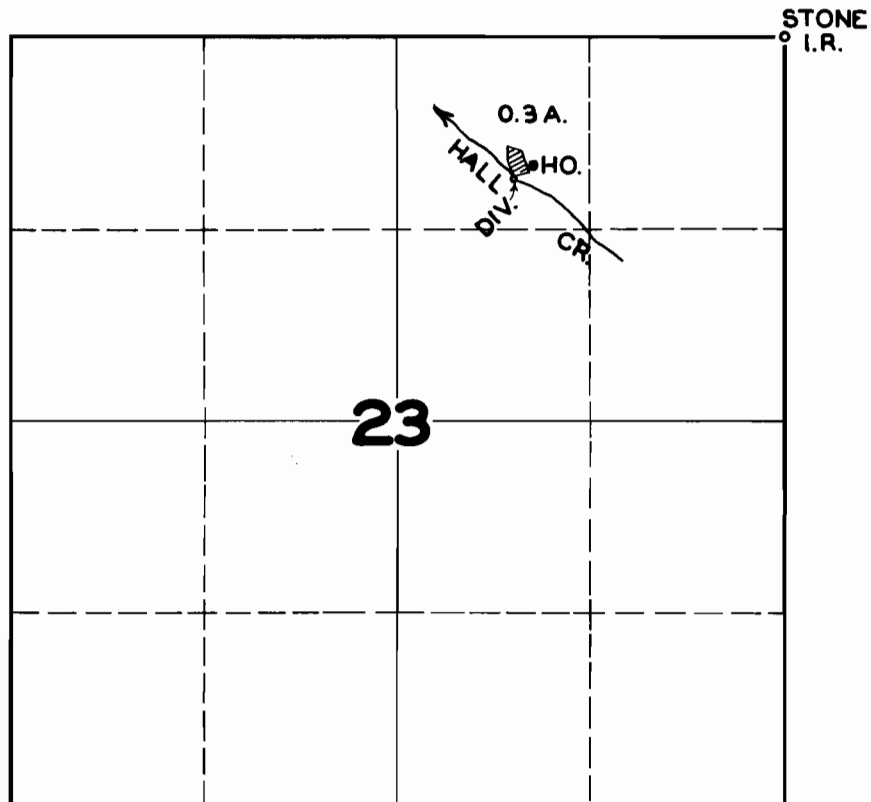

FINAL PROOF SURVEY
UNDER

Application No. **20729** Permit No. **16229**
IN NAME OF

CLARENCE J. LOWRY

Surveyed **JUNE 15, 1948**, by **JAS. E. BUNNELL**