


T.7S.R.4W.W.M.

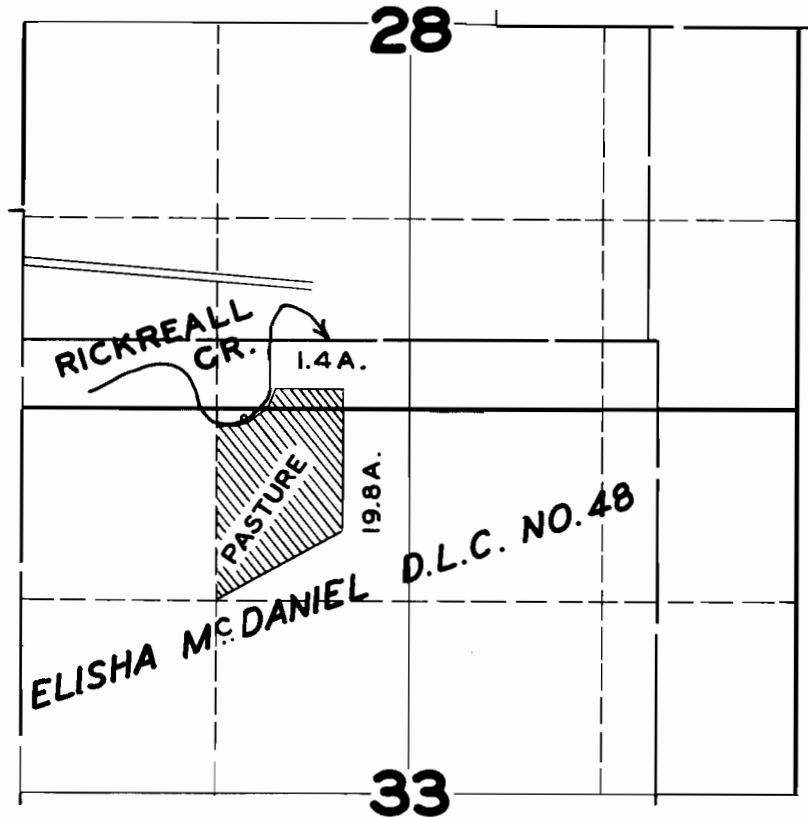

FINAL PROOF SURVEY
UNDER

Application No. **20664** Permit No. **16165**
IN NAME OF

ELMER BICE

Surveyed **MAR. 26 1948**, by **JAS. E. BUNNELL**