


T.17S.R.9W.W.M.

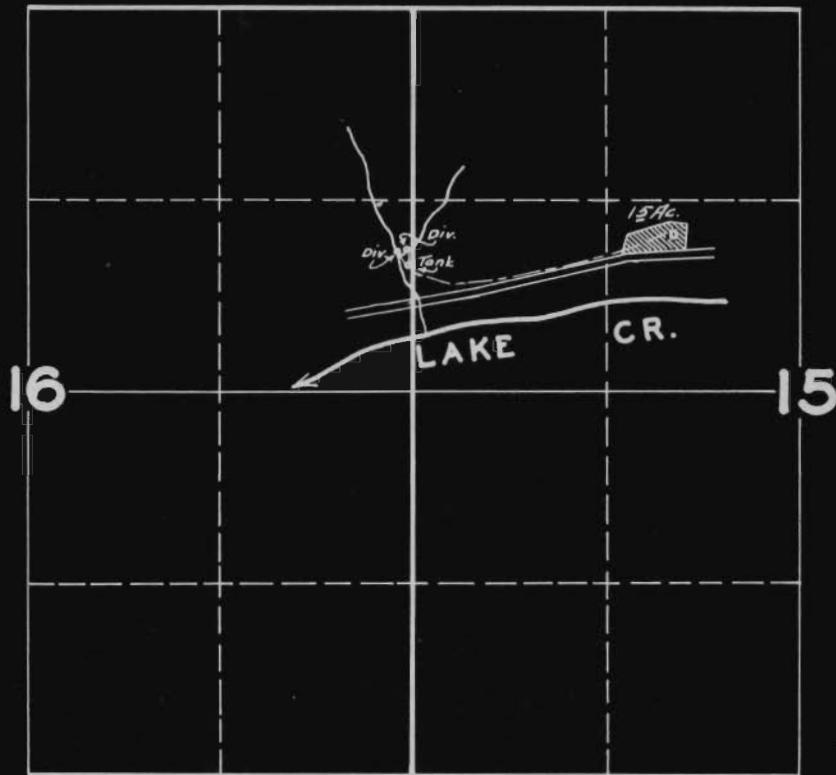

FINAL PROOF SURVEY

UNDER

Application No. 21760 21082 Permit No. 17118 16456

IN NAME OF

P. J. PELTIER

Surveyed AUG. 11, 1947, by JAS. E. BUNNELL