


T.17S. R.9W. W.M.

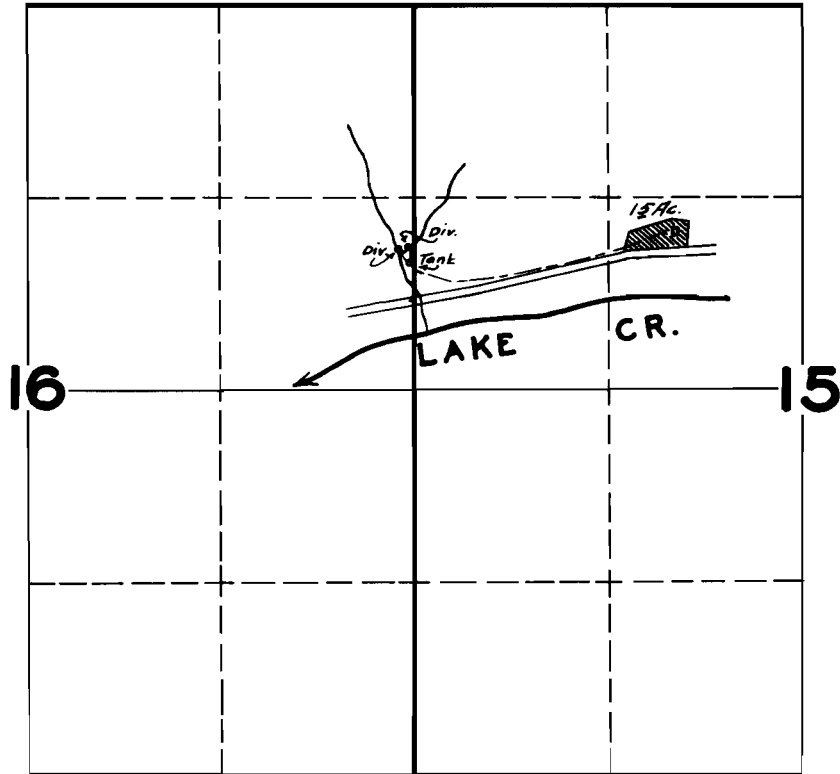

FINAL PROOF SURVEY

UNDER

Application No. ²¹⁷⁶⁰~~21082~~ Permit No. ¹⁷¹¹⁸~~16456~~

IN NAME OF

P. J. PELTIER

Surveyed AUG. 11, 1947, by JAS. E. BUNNELL