


T. 1 S. R. 3 W. W. M.

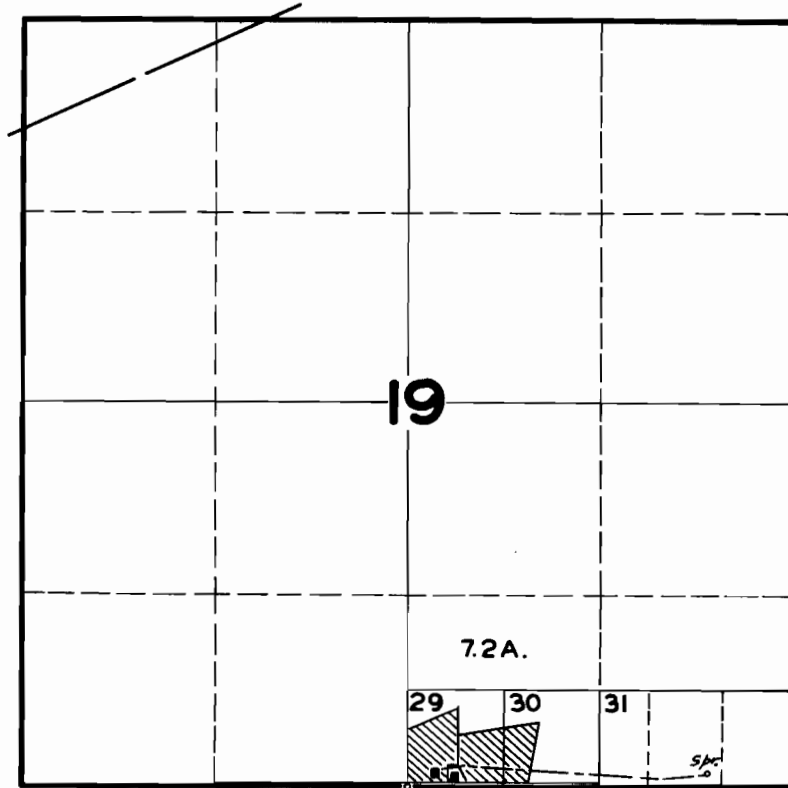

FINAL PROOF SURVEY
UNDER

Application No. **21108** ... Permit No. **16541** ...
IN NAME OF

ERNEST ZAGELOW & EOLA ZAGELOW

Surveyed **MAY 17** 1948, by **JAS. E. BUNNELL**