


T.4S. R.2E.W.M.

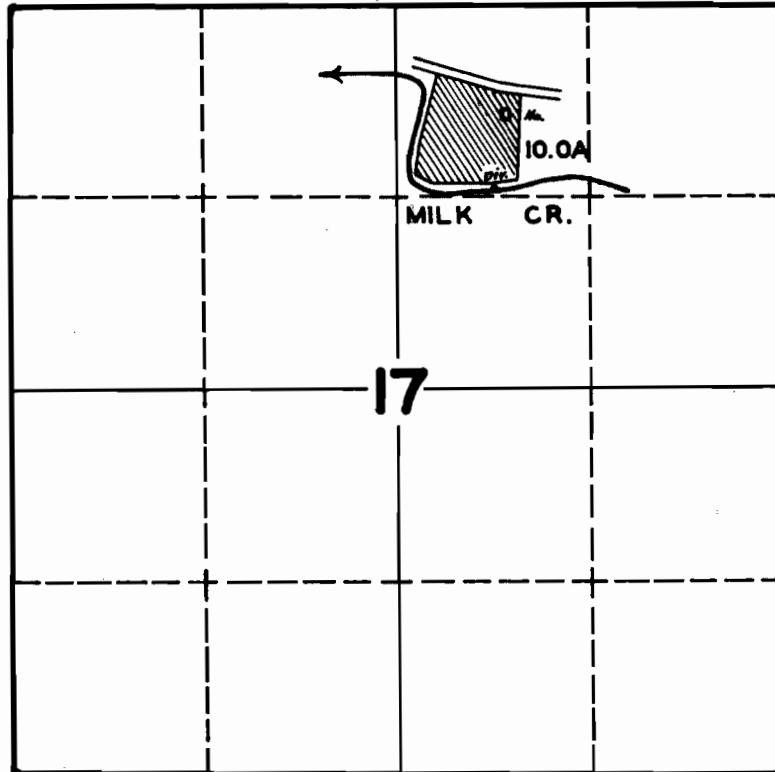

**FINAL PROOF SURVEY
UNDER**

Application No. 21237 Permit No. 16645

IN NAME OF

L. I. BAUGHMAN

Surveyed JUN. 16 1945, by JAS. E. BUNNELL