


T.28S.R.12W.W.M.

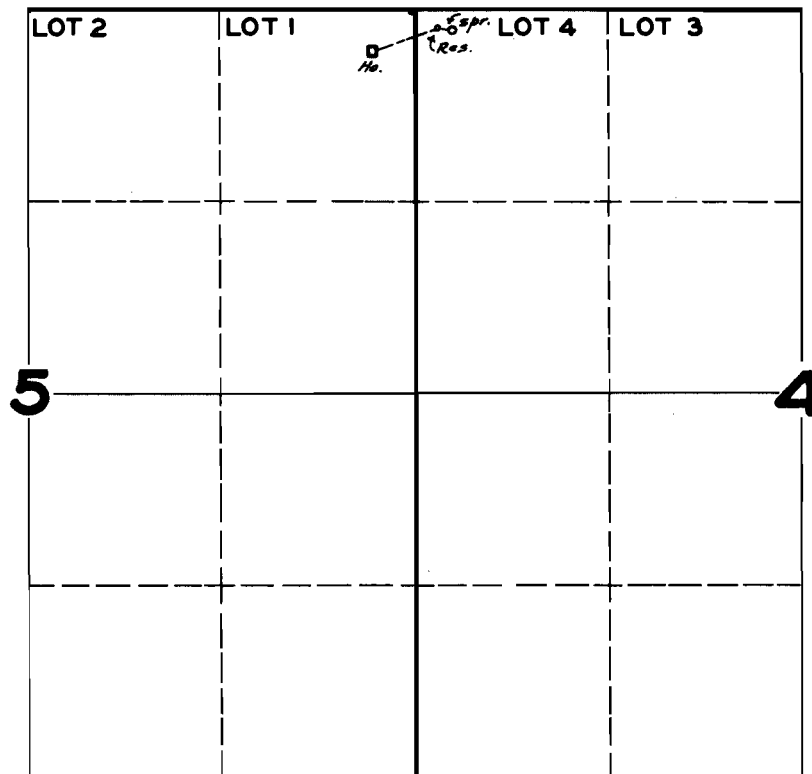

SURVEY OF J. N. GEARHART- ACCEPTED

**FINAL PROOF SURVEY
UNDER**

Application No. 21312 Permit No. 16713

IN NAME OF

L. W. CLAVER

Surveyed AUG. 21 1947, by JAS. E. BUNNELL