


T.4S.R.4W.W.M.

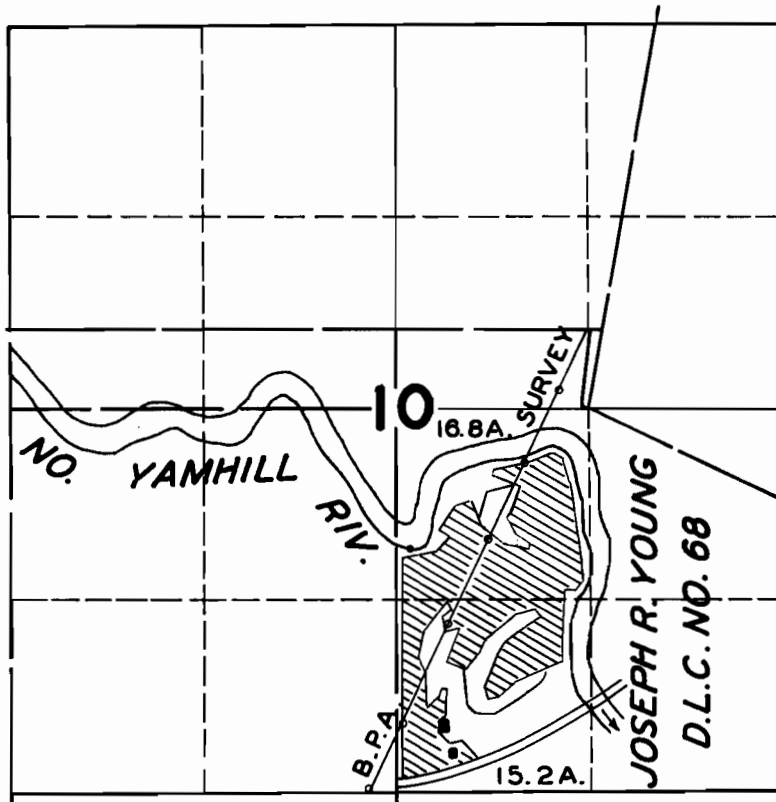

**FINAL PROOF SURVEY**

UNDER

Application No. 21426 Permit No. 16808

IN NAME OF

ESTHER MOORE CLEMMENS

Surveyed MAY 4 1949, by JAS. E. BUNNELL