


T.4S.R.3E.W.M.

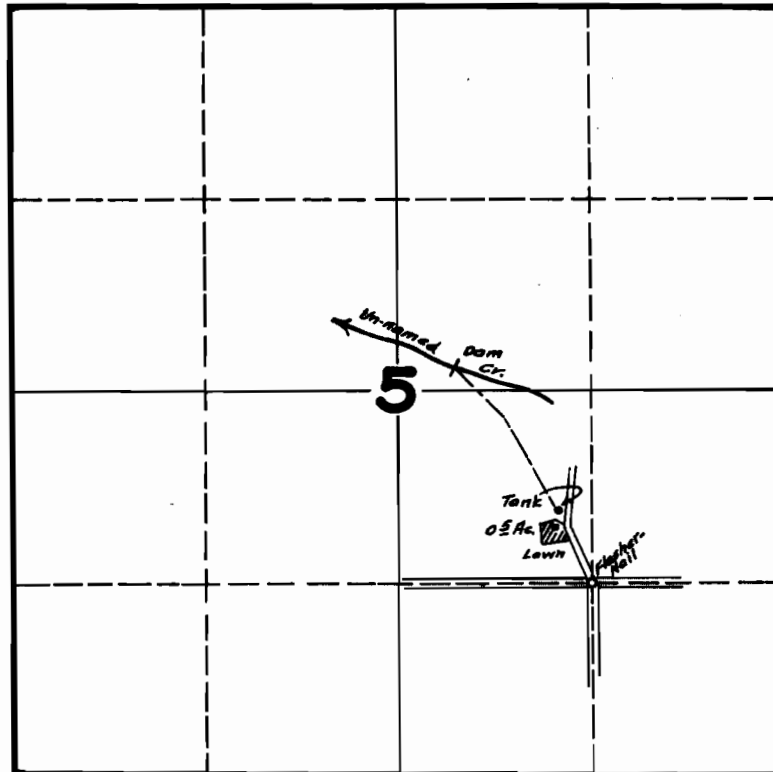

**FINAL PROOF SURVEY
UNDER**

Application No. 21673 Permit No. 17020

IN NAME OF

VERNON NEELY

Surveyed JUN. 20 1947, by JAS. E. BUNNELL