


T.9S.R.2E.W.M.

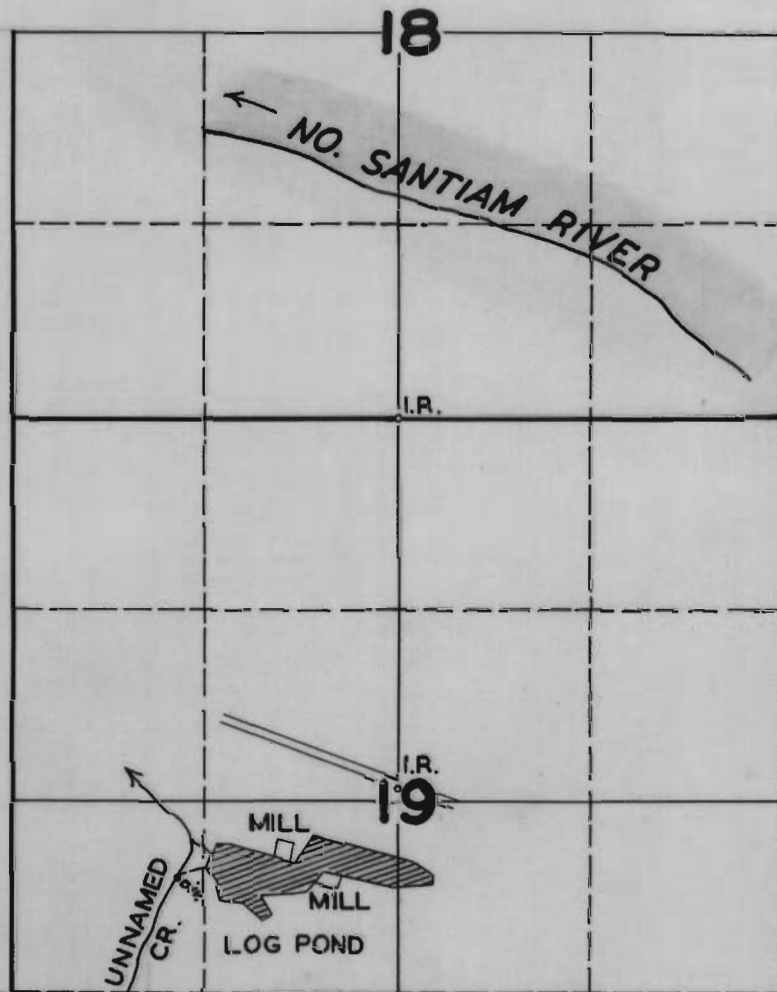

**FINAL PROOF SURVEY**  
UNDER

Application No. 21744 Permit No. 17218  
IN NAME OF

MT. JEFFERSON LUMBER CO.

Surveyed APR. 15, 1948, by JAS. E. BUNNELL