


T.15S.R.12W.W.M.

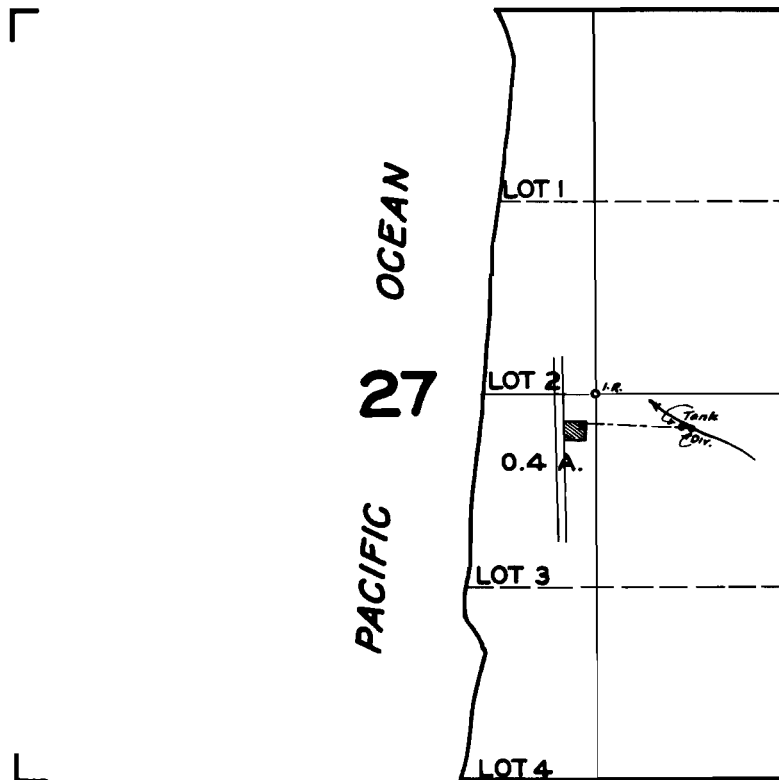

**FINAL PROOF SURVEY
UNDER**

Application No. 21711 Permit No. 17045

IN NAME OF

R.G. DE SART

Surveyed AUG. 13 1947, by JAS. E. BUNNELL