


T.5S.R.1W.W.M.

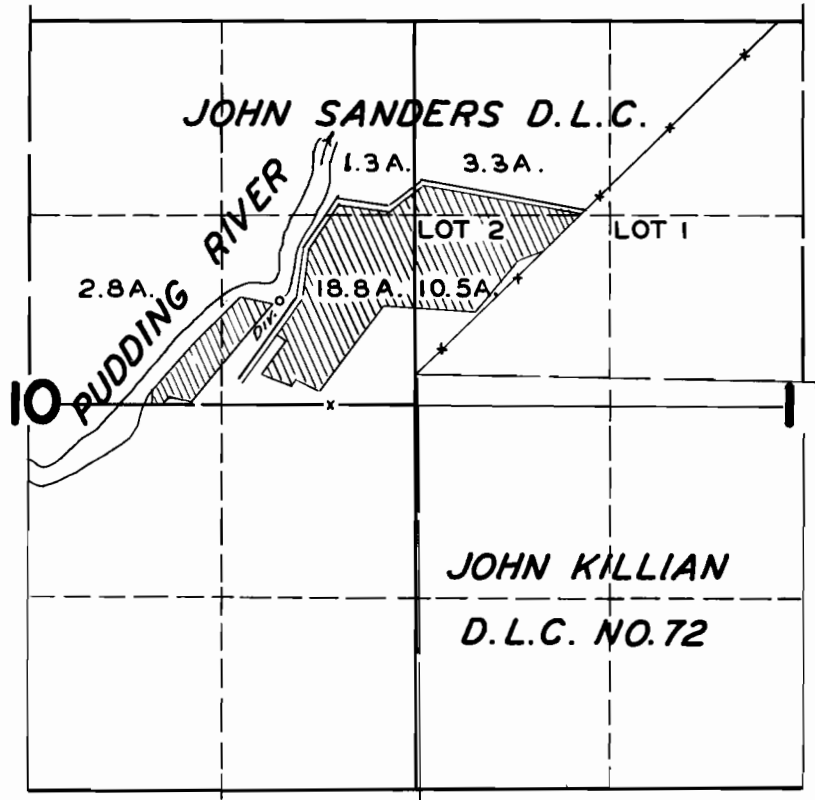

FINAL PROOF SURVEY

UNDER

Application No. **21857** Permit No. **17191**

IN NAME OF

JOHN W. RAMAGE

Surveyed **MAY 2** 1949, by **JAS. E. BUNNELL**