


T. 2S. R. 1W. W. M.

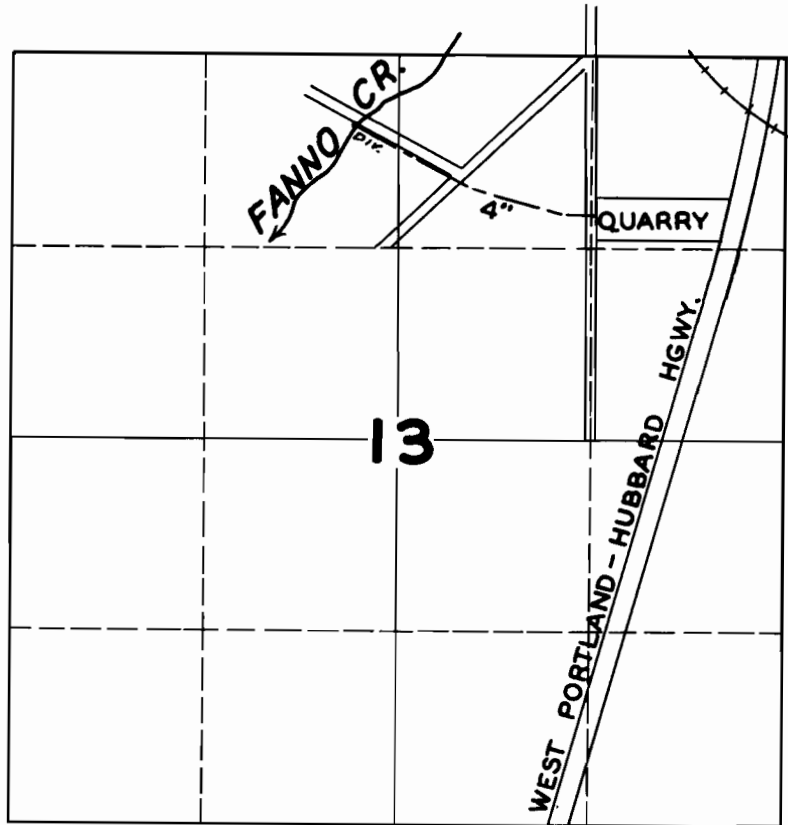

FINAL PROOF SURVEY

UNDER

Application No. ~~21826~~... Permit No. ~~17223~~...

IN NAME OF

..... JOHN MCCARTHY

Surveyed MAY 4 1948, by JAS. E. BUNNELL