


T.3S.R.9W.W.M.

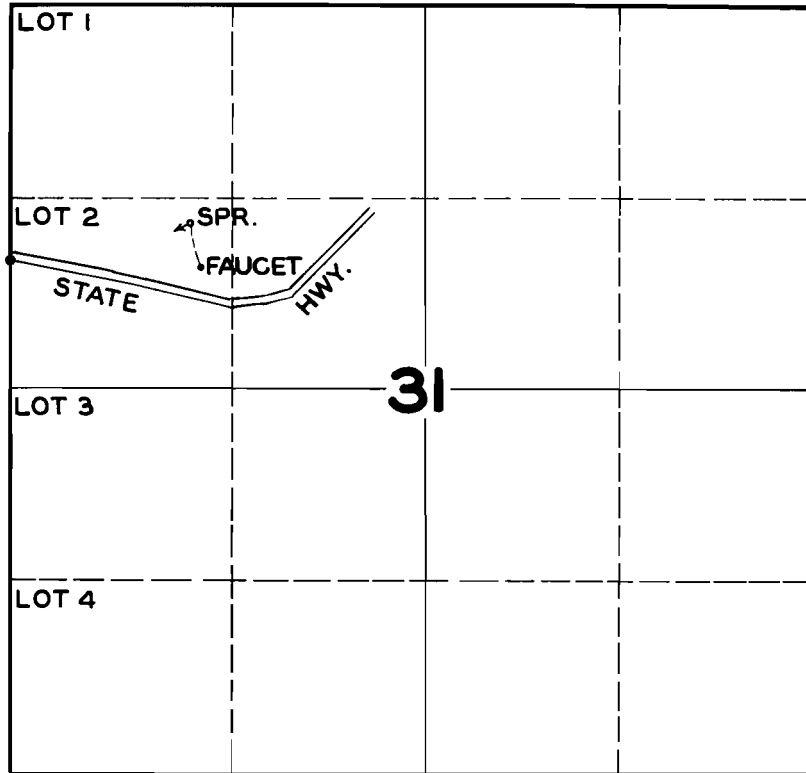

FINAL PROOF SURVEY UNDER

Application No. 22700 Permit No. 17889
IN NAME OF

WALTER J. & ANNA M. BONES

Surveyed AUG. 30, 1948, by JAS. E. BUNNELL