


T.2S.R.1E.W.M.

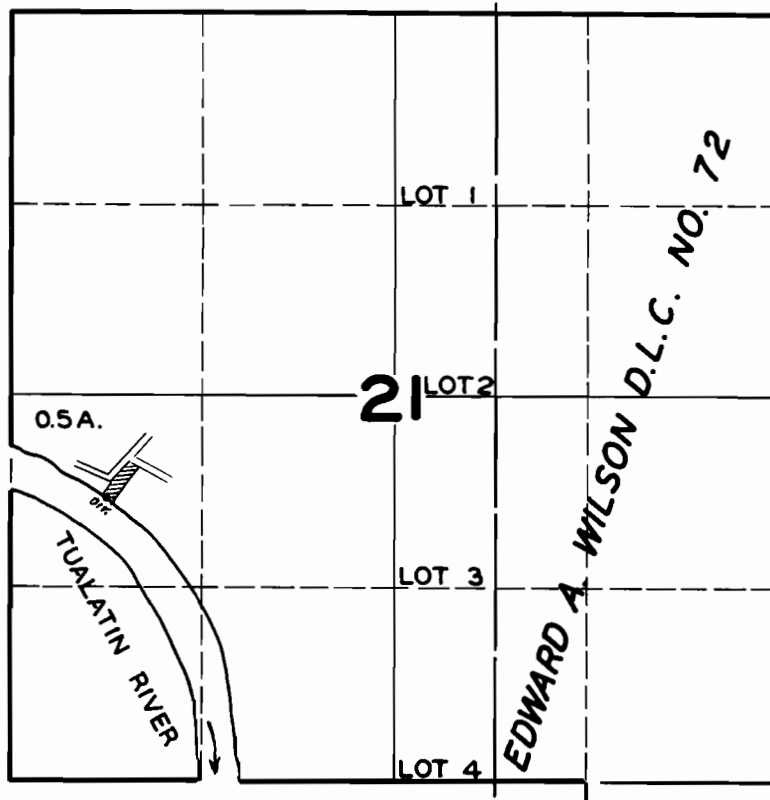

FINAL PROOF SURVEY UNDER

Application No. **22321**... Permit No. **17599**...
IN NAME OF

ELIZABETH M. TROWBRIDGE

Surveyed **JULY 6, 1948**, by **JAS. E. BUNNELL**