


T.8S.R.10W.W.M.

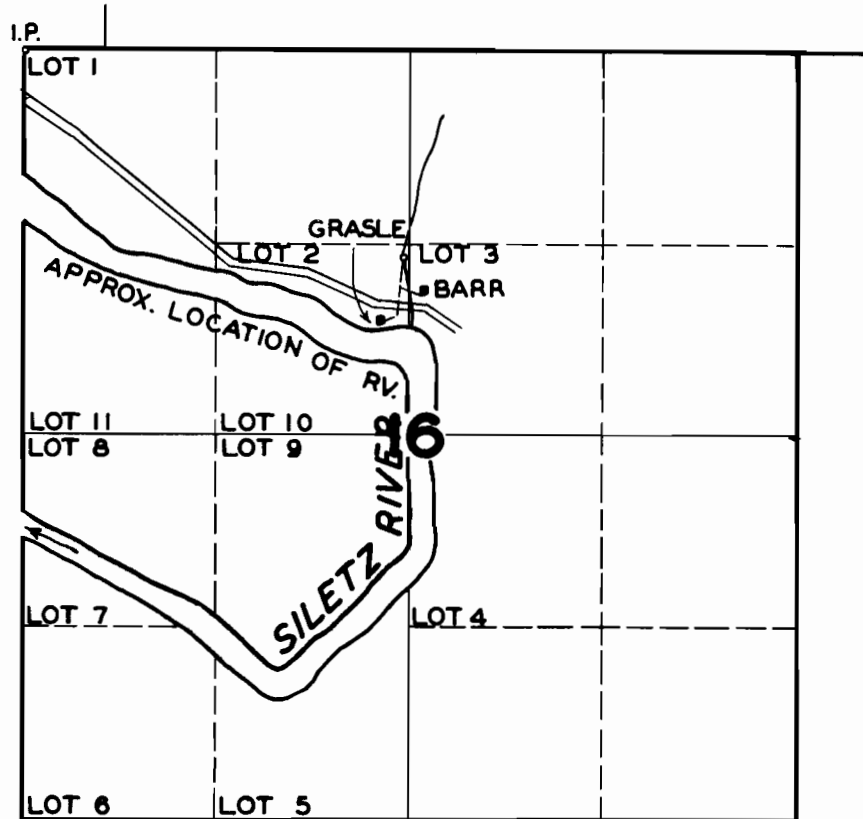

FINAL PROOF SURVEY UNDER

Application No. **22948** Permit No. **18126**
IN NAME OF

ARTHUR W. BARR

Surveyed **AUG. 9** 1948, by **JAS. E. BUNNELL**