


T.2S.R.IE.W.M.

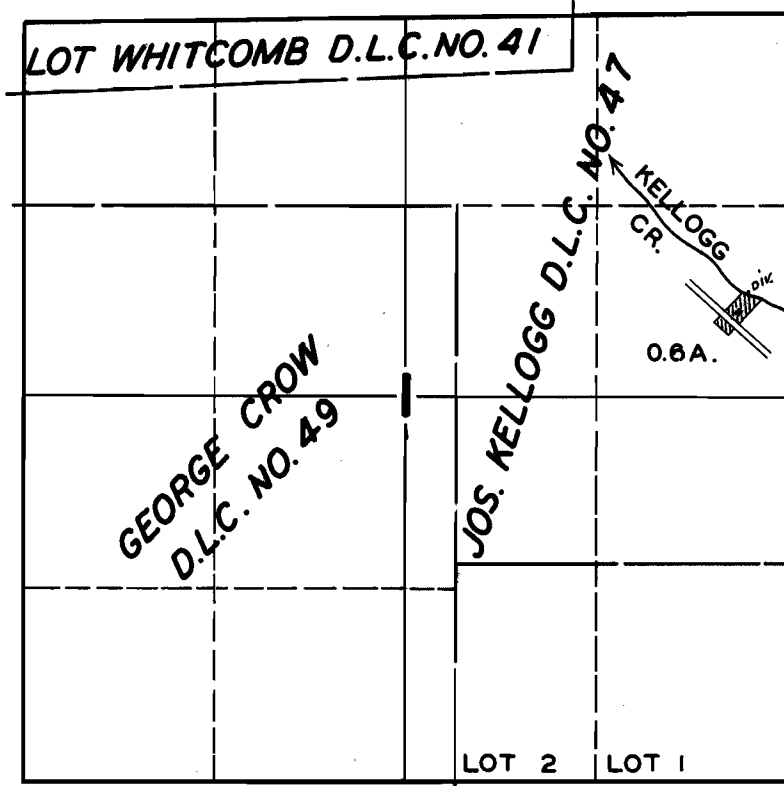

FINAL PROOF SURVEY UNDER

Application No. 23028 Permit No. 18146
IN NAME OF

CHARLES E. NICHOLSON, JR. & THELMA F. NICHOLSON

Surveyed JULY 6 1948, by JAS. E. BUNNELL