


T.4S.R.2E.W.M.

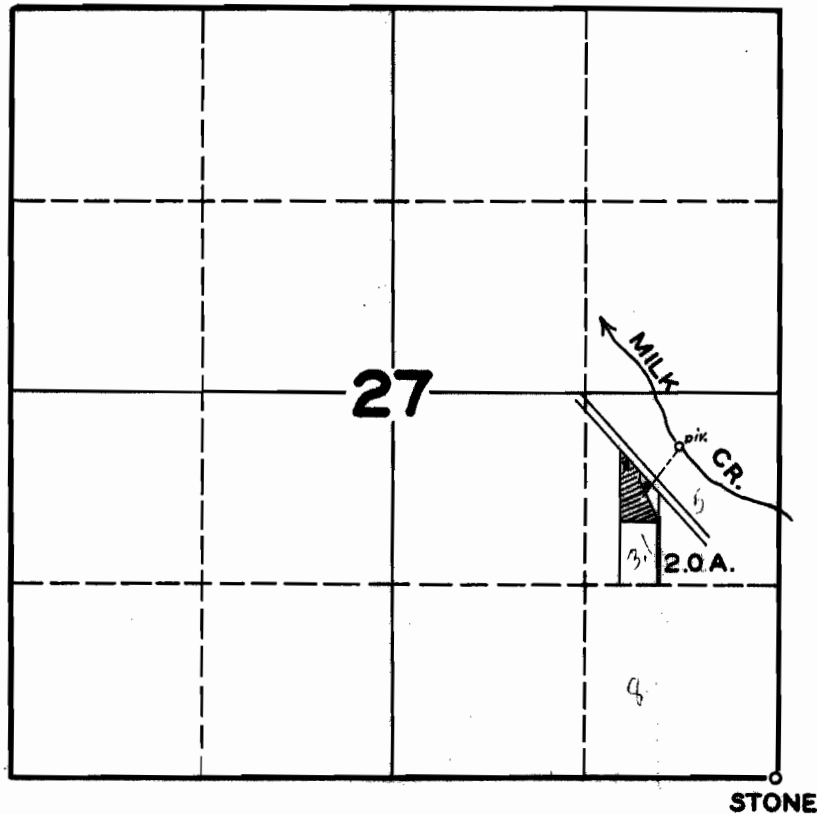

FINAL PROOF SURVEY
UNDER

Application No. **23039** Permit No. **18151**.....
IN NAME OF

.....**DONALD MORRIS**.....

Surveyed **AUG. 5** 1948, by **JAS. E. BUNNELL**