


U-86
C-7070

T.6N.R.35E.W.M.

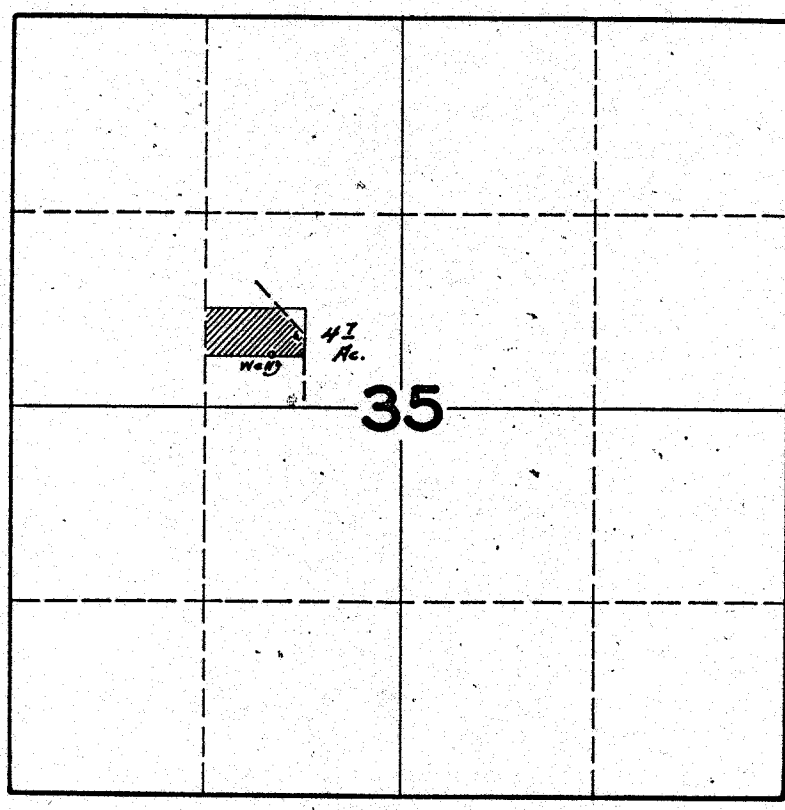

FINAL PROOF SURVEY UNDER

Application No. U-92 Permit No. U-86

IN NAME OF
FRED SAMS

Surveyed APR. 22 1947, by JAS. E. BUNNELL