


# T.17S.R.1E.W.M.

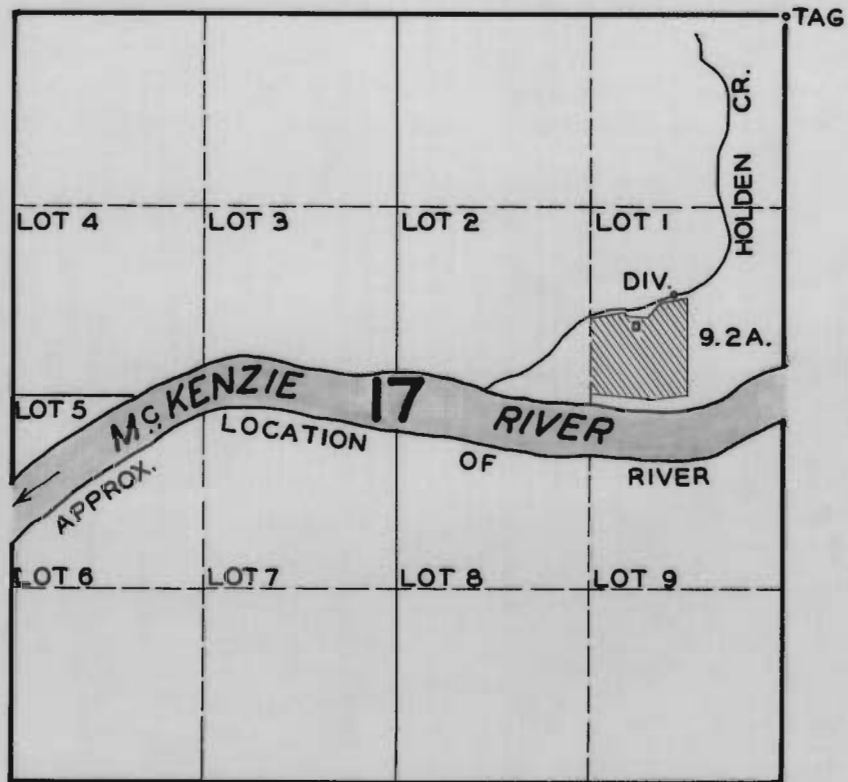

## FINAL PROOF SURVEY UNDER

Application No. 14804 Permit No. 10769  
IN NAME OF

B.K. JOURNEY & FLORENCE JOURNEY

Surveyed JUNE 16, 1948, by JAS. E. BUNNELL