


T.3S.R.2W.W.M.

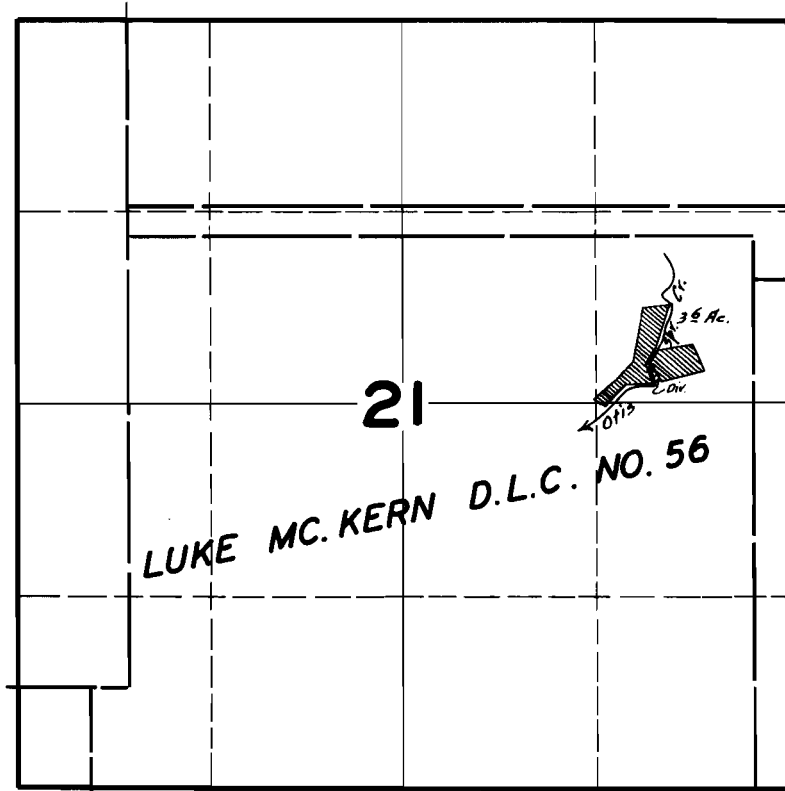

FINAL PROOF SURVEY
UNDER

Application No. 16084 Permit No. 11881

IN NAME OF

THOMAS BURNS

Surveyed MAR. 7, 1946, by [Signature]